


T. 29 & 30 S. R. 5 W. W.M.

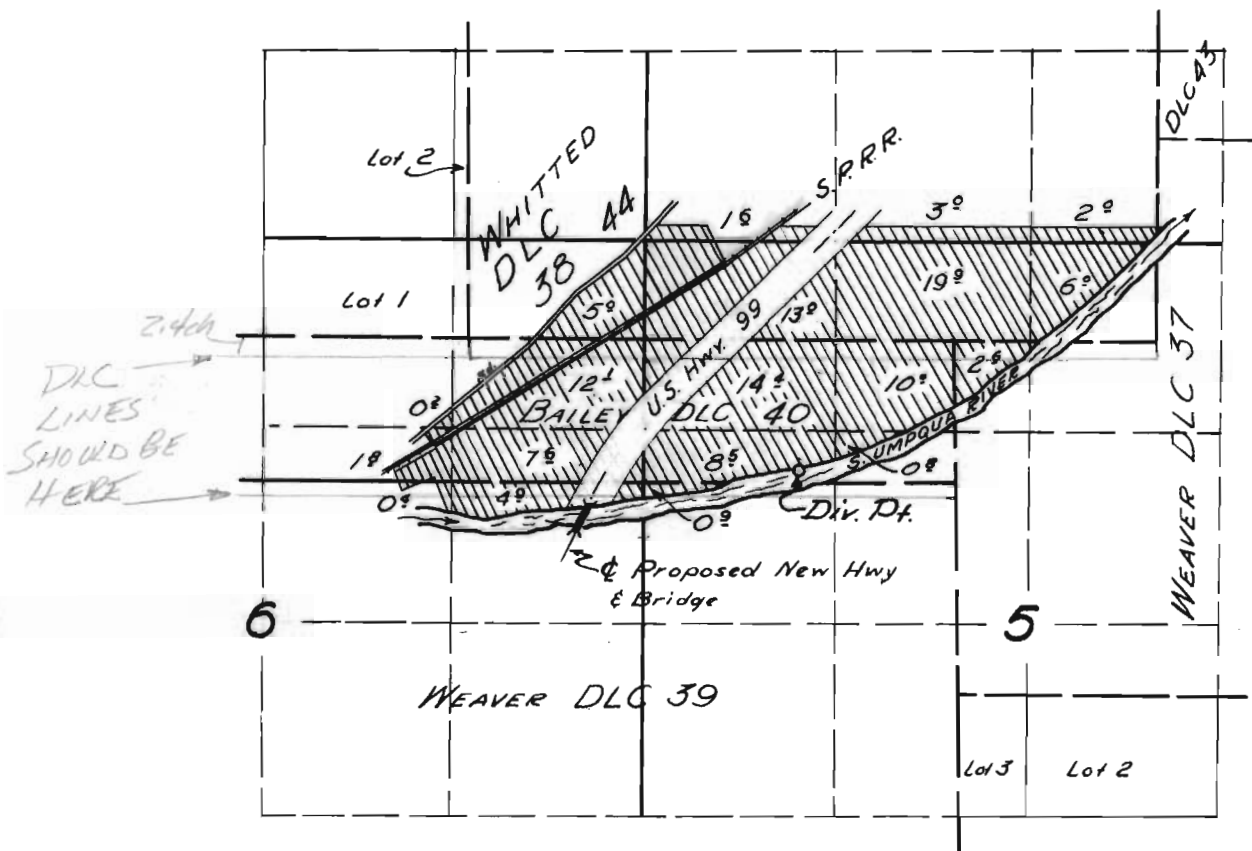

FINAL PROOF SURVEY

UNDER

Application No. 24436 Permit No. 19266

IN NAME OF

G. N. WEAVER

Surveyed 11 Oct. 1956, by *[Signature]*