T. IN., R. 4W., W.M.

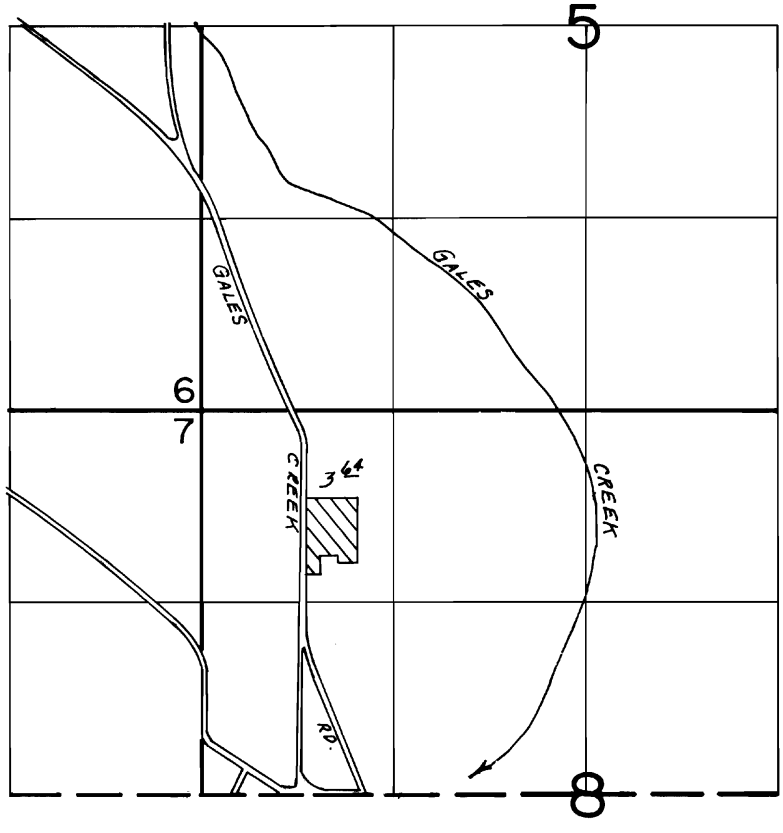

FINAL PROOF SURVEY
UNDER

Transfer No. 3748
Application No. ..... Permit No. .....
IN NAME OF

EARL A., JR. & DONNA F. SMITH

Surveyed JULY 16 1980, by R.G. MUCKEN

DBS-2LL-98
BWB