


# T. 35 S., R. 1 W., W.M.

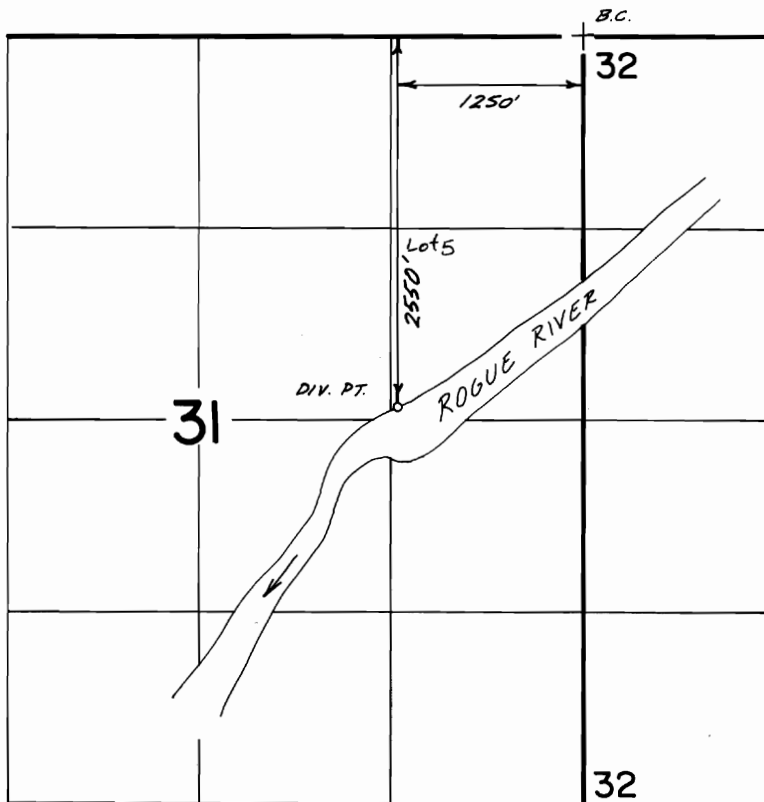

Scale 1" = 1320'

## FINAL PROOF SURVEY UNDER

Transfer No. 3749

Application No. .... Permit No. ....

IN NAME OF

..... R. B. BEWLEY .....

Surveyed Nov. 19... 1985, by B.S. JAMES.....