


T. 6N. R. 35E. W. M.

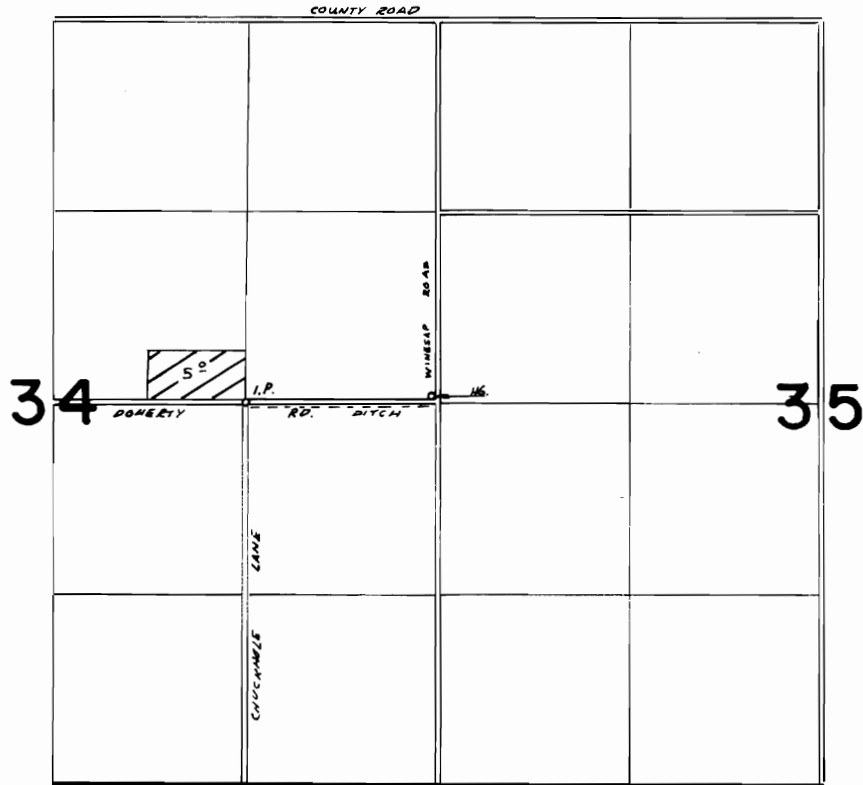

FINAL PROOF SURVEY
UNDER

TRANSFER 3760

Application No. Permit No.

IN NAME OF

..... **HULETTE JOHNSON**

Surveyed 6-26 1979, by V. CHURCH