

To

SEC. 9 T.17 S. R.12 E. W.M.

17 12


DESCHUTES COUNTY

SCALE: 1" = 400'

See Map 17 12 4

T-3772

601
604
605 } 5A Pond/Quartz

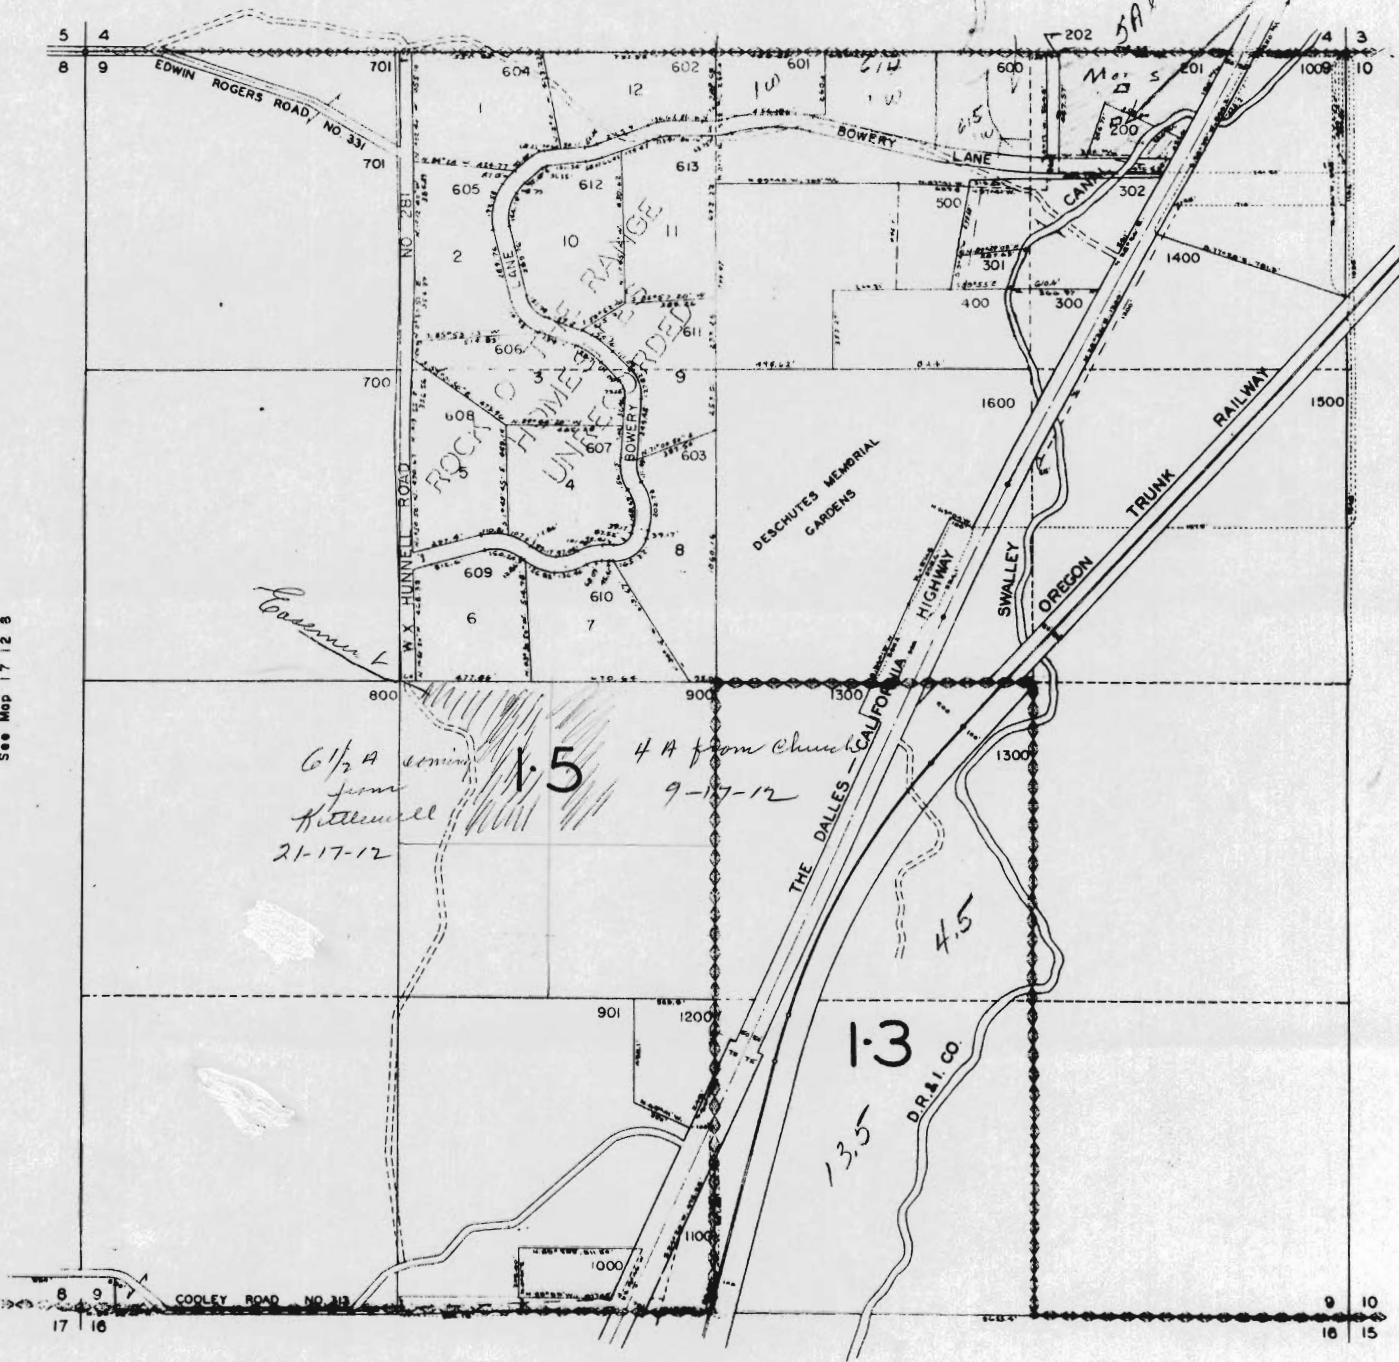

See Map 17 12 8

See Map 17 12 16

17 12

RECEIVED

SEP - 8 1977

WATER RESOURCES DEPT
SALEM, OREGON

