


RECEIVED

SEP 23 1977

WATER RESOURCES DEPT  
SALEM, OREGON

FROM

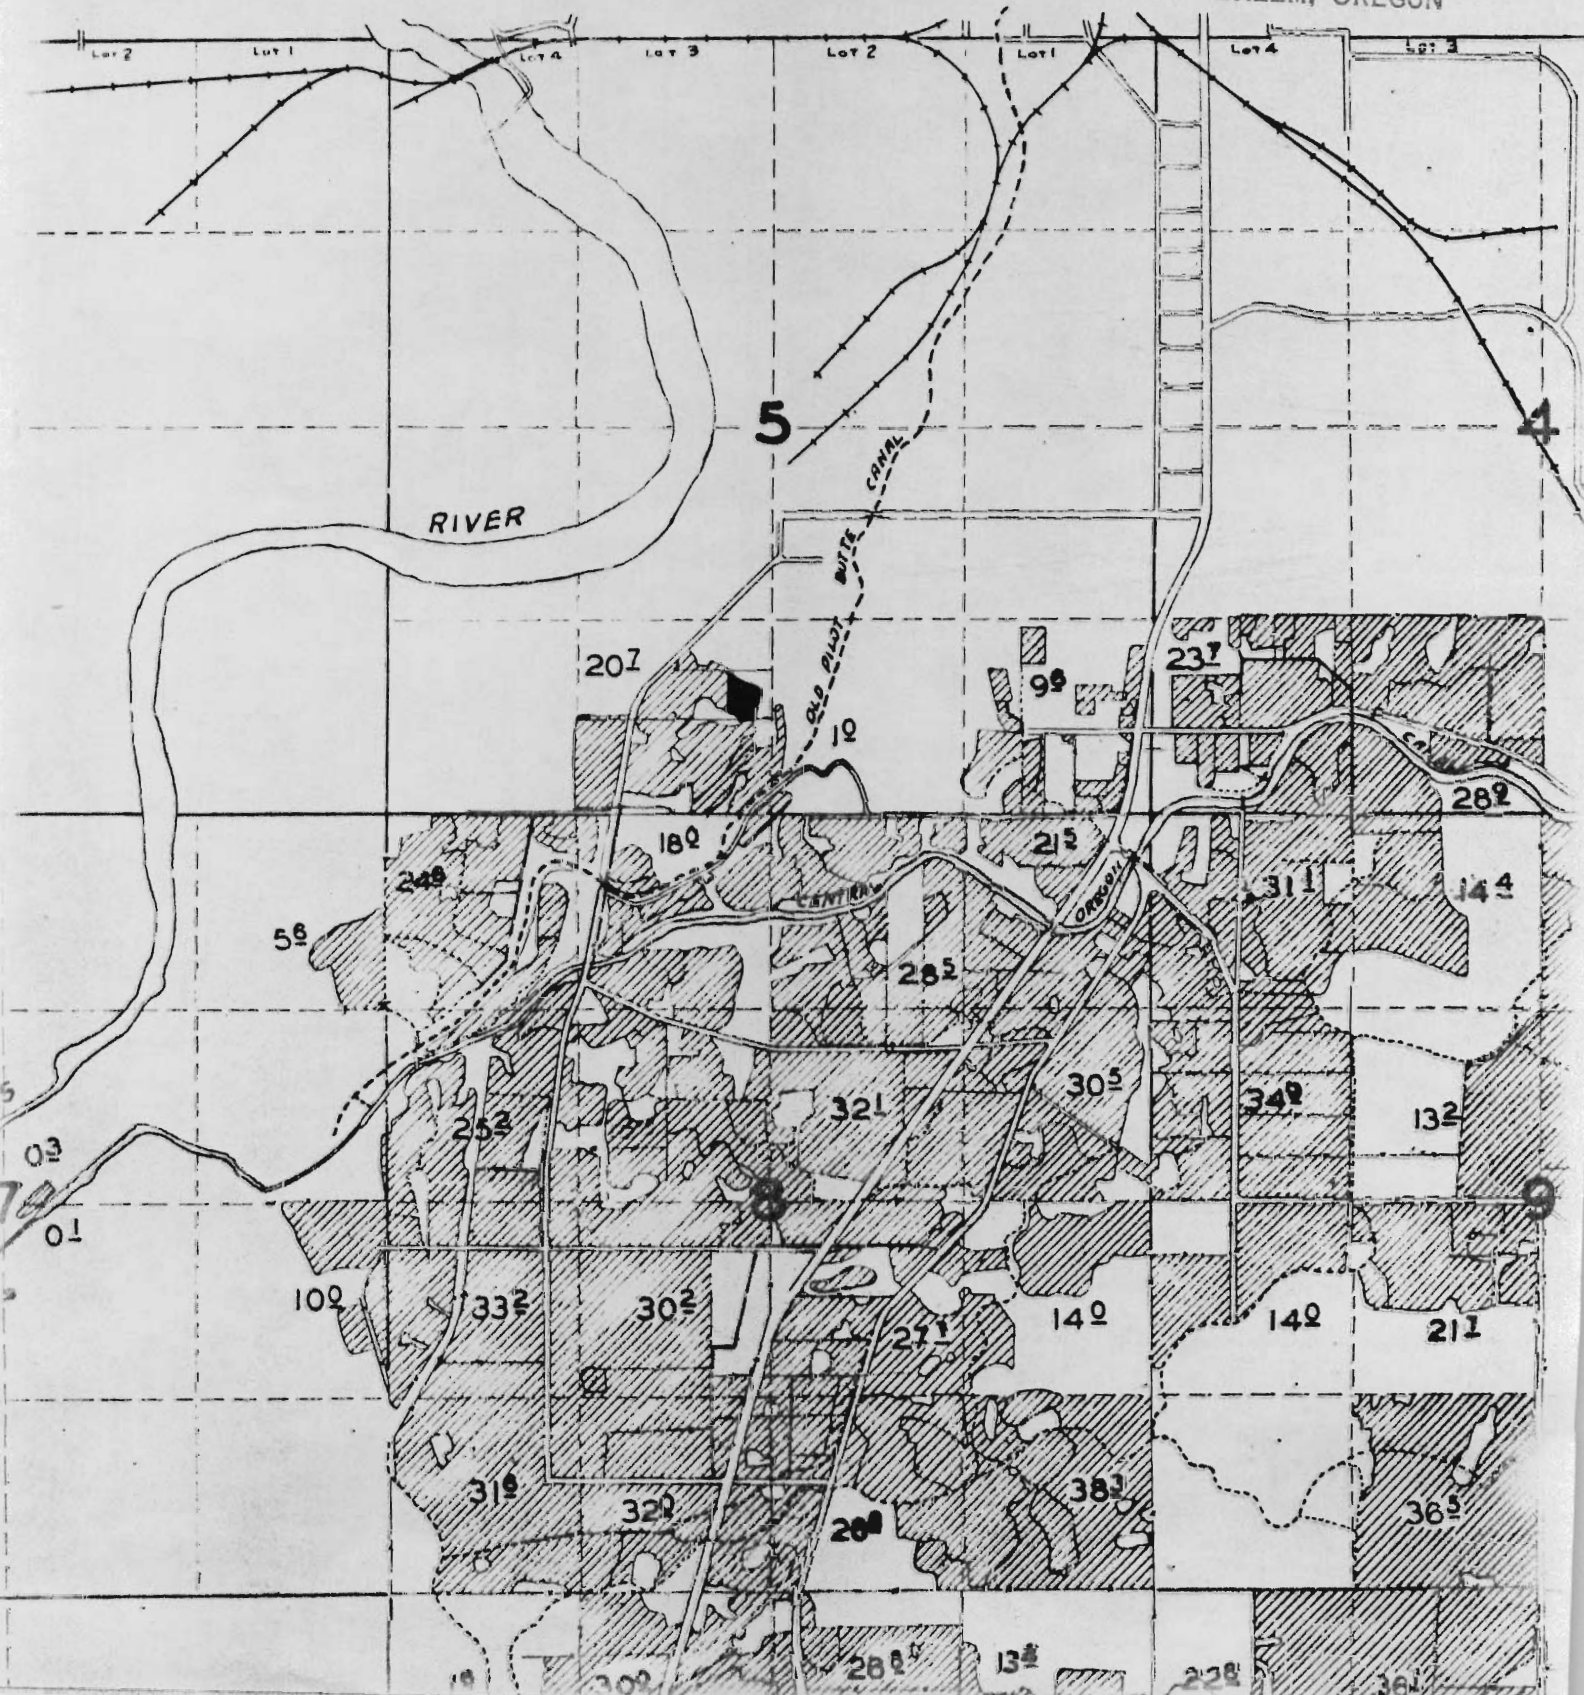

RECEIVED

SEP 23 1977

WATER RESOURCES DEPT  
SALEM, OREGON

TO

