



T.18S. R.12E. W.M

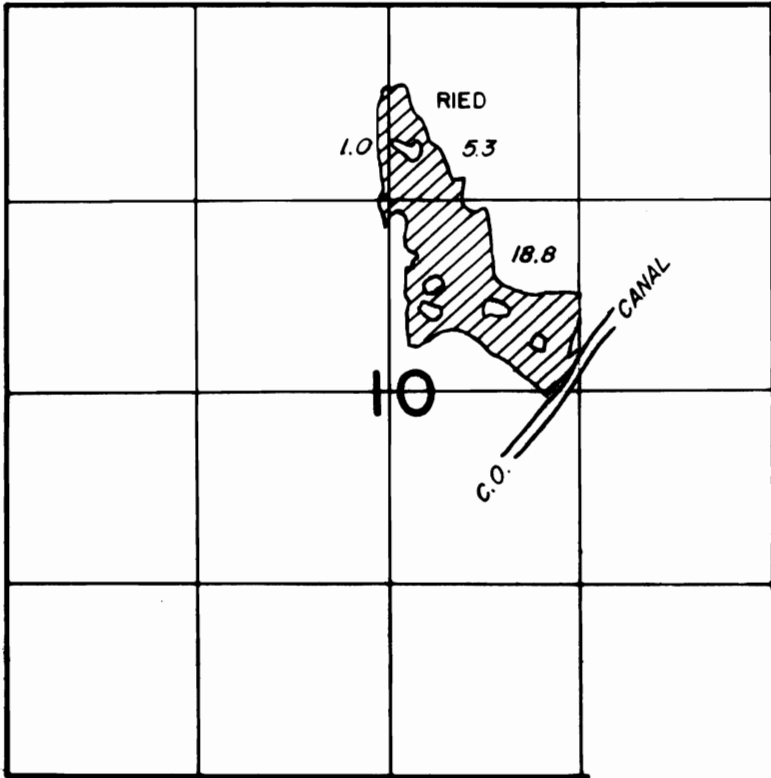

T.17S. R.13S. W.M.

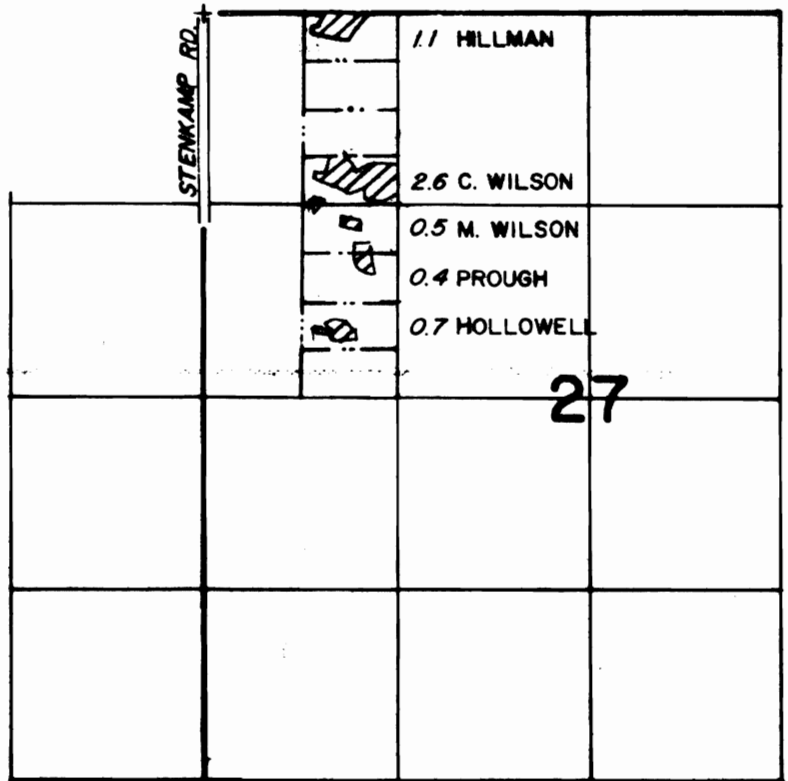

FINAL PROOF SURVEY
UNDER

TRANSFER 3788
Application No. Permit No.

IN NAME OF

SEE ABOVE

Surveyed MAY...25... 1982., by L.H. NUJN.....