


TOWNSHIP 16 SOUTH, RANGE 14

RECEIVED

SEP 23 1977

WATER RESOURCES DEPT
SALEM, OREGON

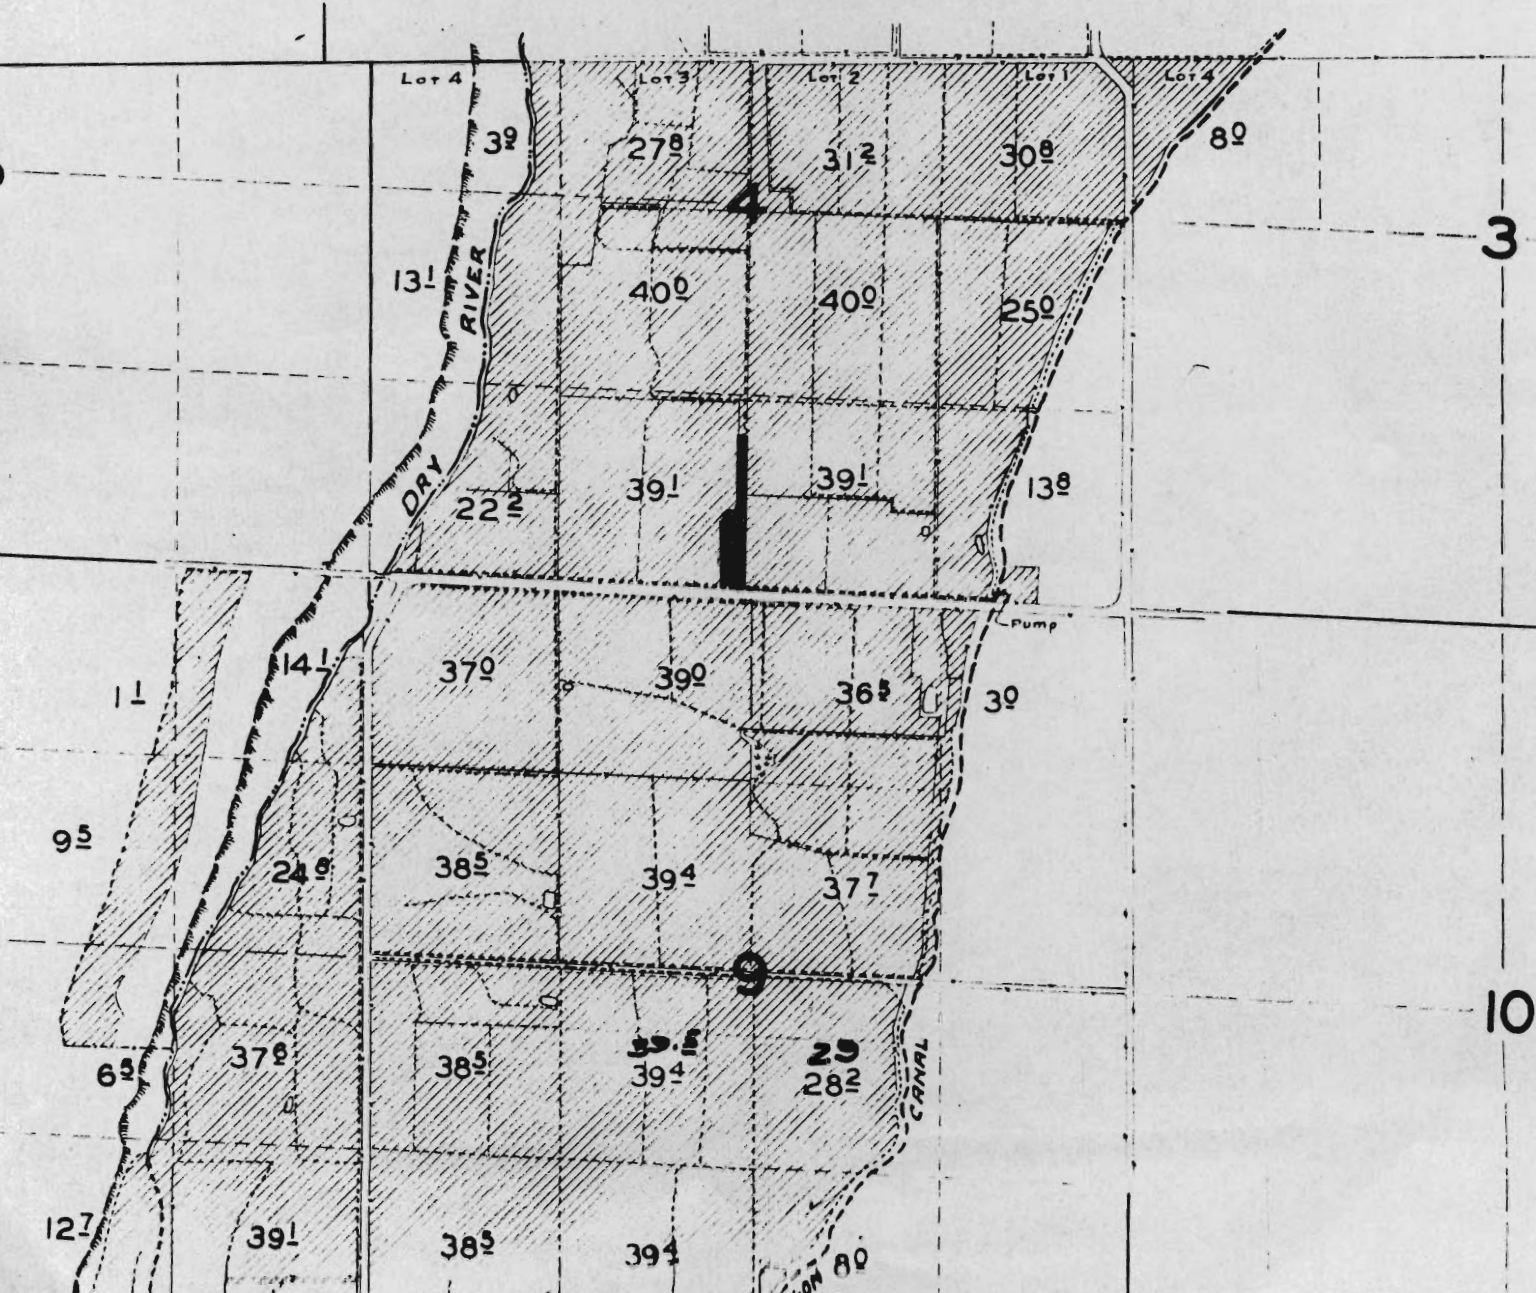

TOWNSHIP 16 SOUTH, RANGE 14

RECEIVED

SEP 23 1977

WATER RESOURCES DEPT
SALEM, OREGON

