

DESCHUTES COUNTY

1" = 100'

See Map 14 13 16 D 0

HIGHWAY STREET (U.S. 97)

16 600	17 801
	692
900	1000
93	1100
	1200
1400	1500
1500	
1	32

C

16 600	17 501
	502
700	500
106	
1	32

16	17 300
400	
102	
(VACATED)	
1	32

100	100
124	
(VACATED)	
(VACATED)	
29	200
32	
129	
(VACATED)	
31	
32	
1	32

DALLES - CALIFORNIA

16	17 1600
1701	1700
1900	1800
92	
2000	
1	32

B

16	17 2400
	2300
107	2201
2200	
1	32

2600	2600	2500
212		
(VACATED)		
125		
(VACATED)		
128		
(VACATED)		
143		
1	32	

NEW

16 2101	17
(VACATED)	
91	OLD
(VACATED)	
1	32

2100	
102	
(VACATED)	
1	32

2700	2600	144
109		
(VACATED)		
126		
(VACATED)		
14th		
127		
(VACATED)		
(VAC)		
1	32	

RECEIVED

OCT 16 1978

WATER RESOURCES DEPT SALEM, OREGON

RECEIVED


SEP 28 1977

WATER RESOURCES DEPT SALEM, OREGON

DESCHUTES COUNTY

1" = 100'

See Map 14 13 16 B D

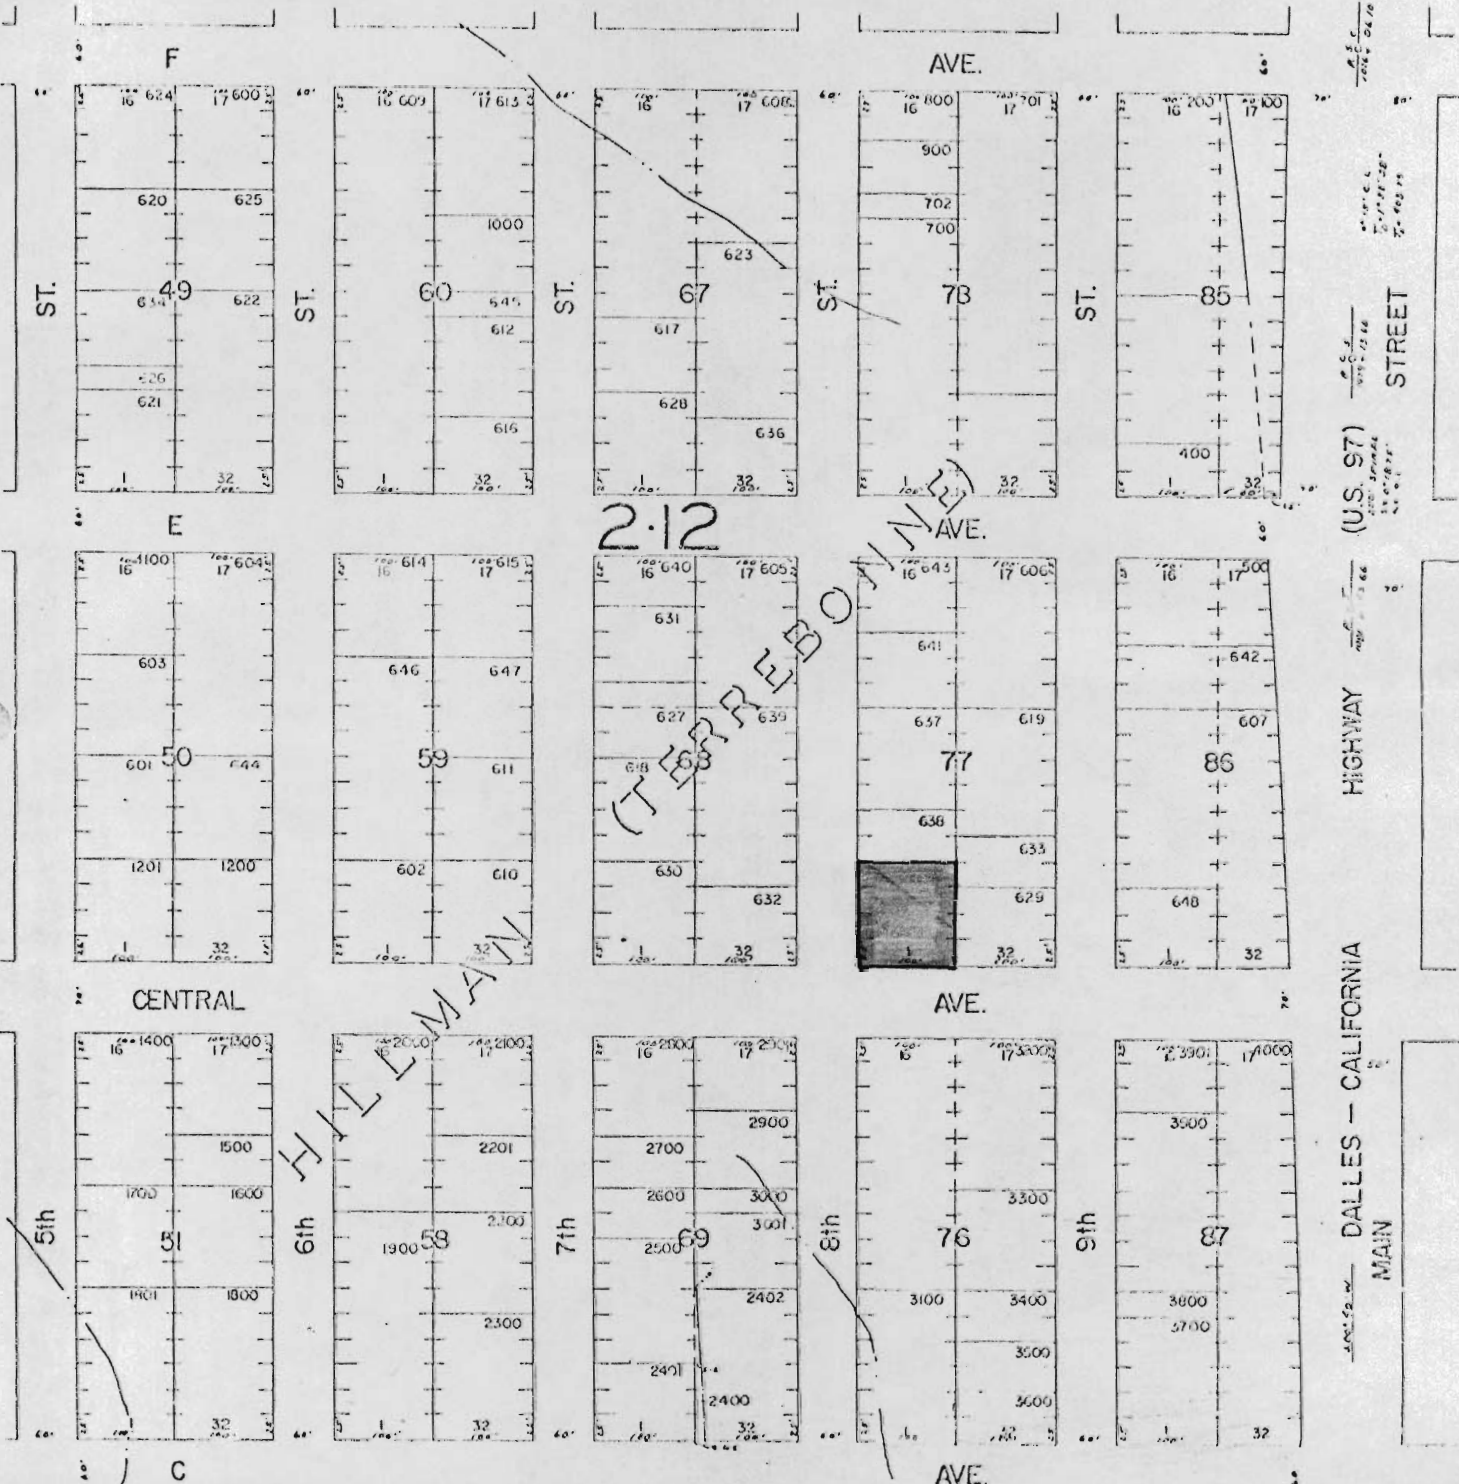

(U.S. 97) STREET

HIGHWAY

DALLAS - CALIFORNIA MAIN

See Map 14 13 16 B

RECEIVED

OCT 16 1978

WATER RESOURCES DEPT. SALEM, OREGON

RECEIVED

SEP 28 1977

WATER RESOURCES DEPT. SALEM, OREGON