

RECEIVED

10-7-65  
11-16-3

OCT 16 1978


WATER RESOURCES DEPT.  
SALEM, OREGON

RECEIVED

SEP 28 1977

WATER RESOURCES DEPT.  
SALEM, OREGON

FROM

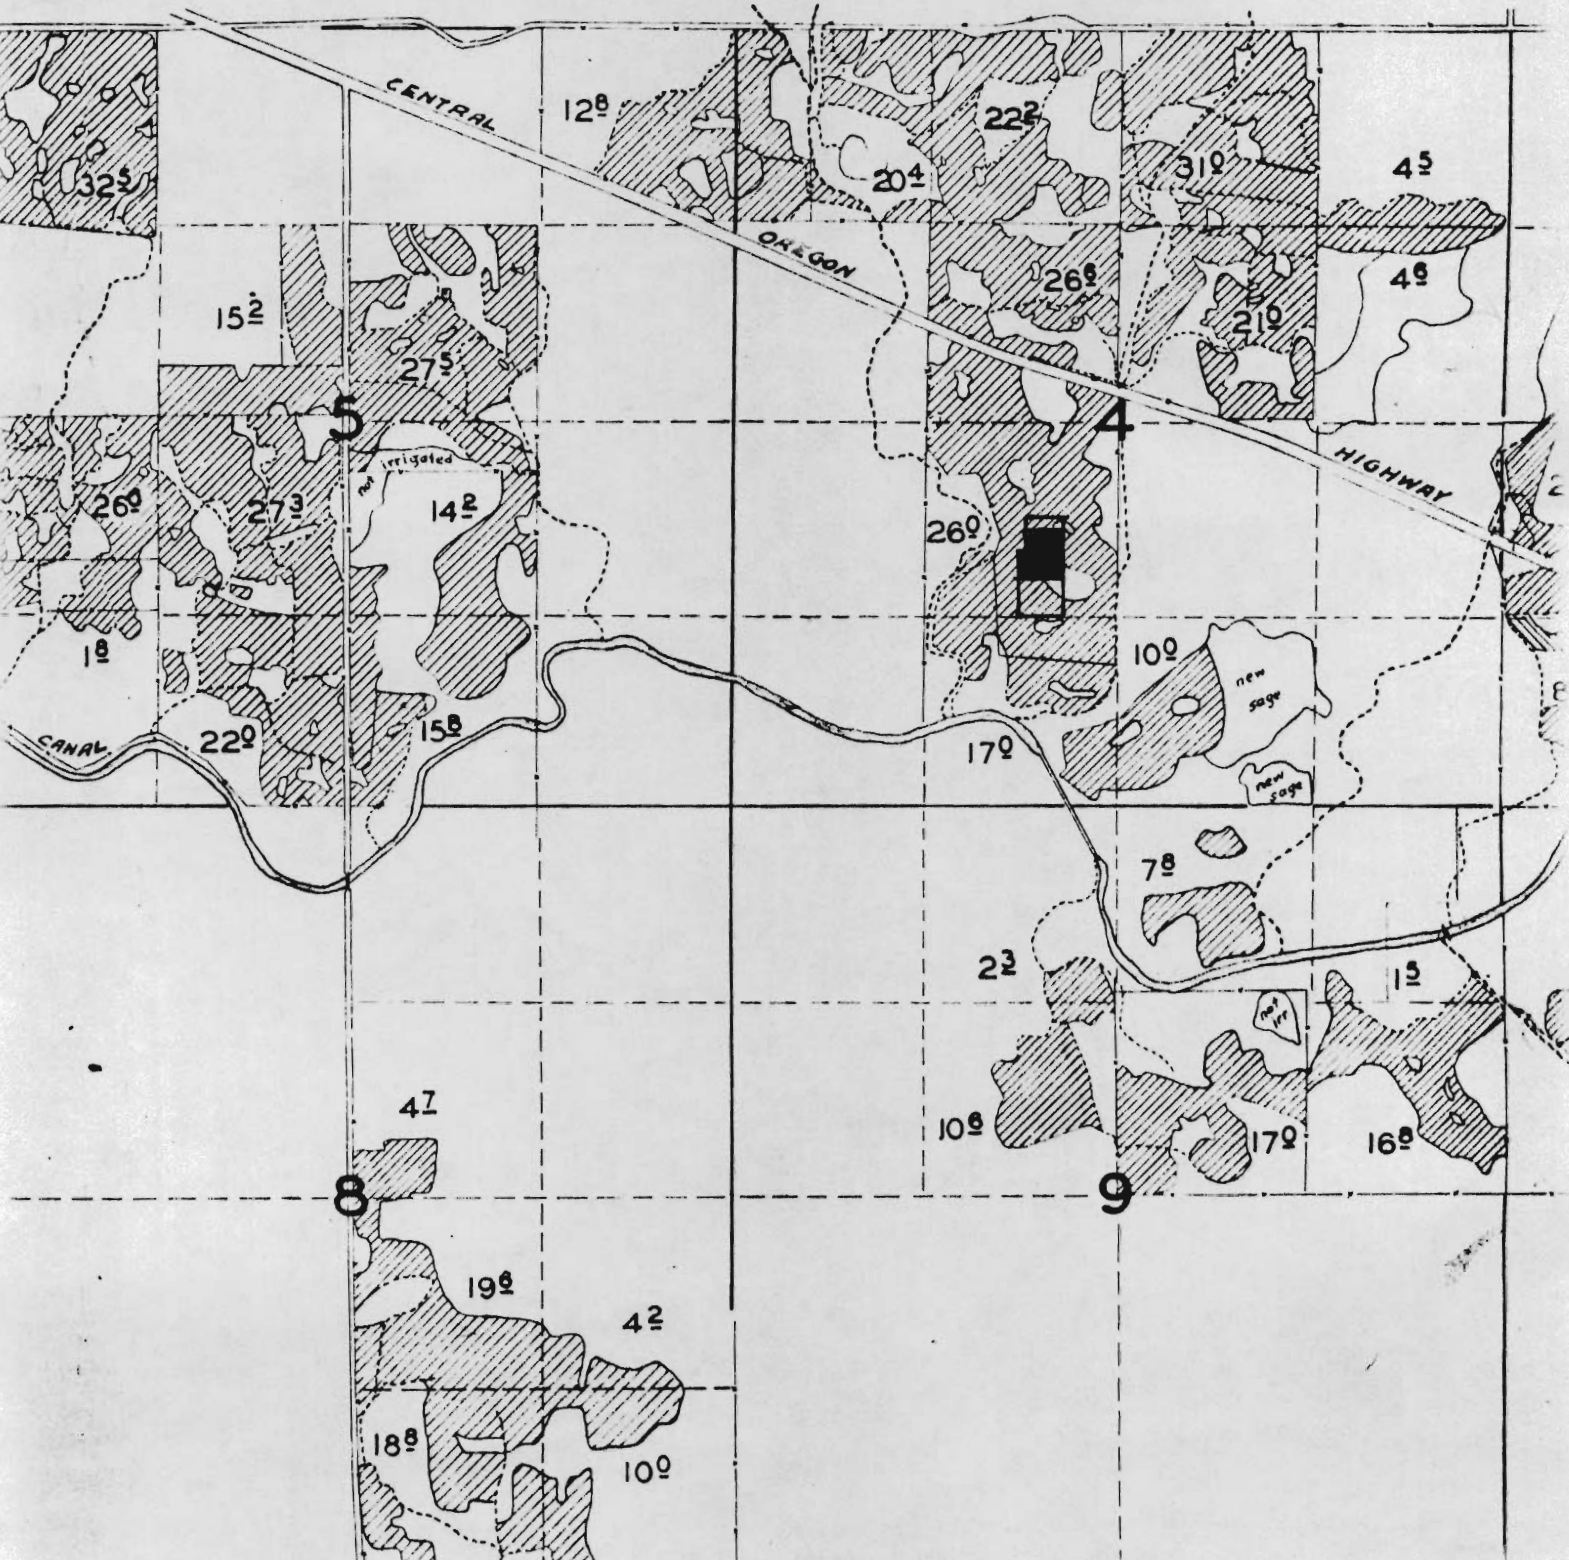

RECEIVED

RECEIVED

OCT 16 1978


SEP 28 1977

WATER RESOURCES DEPT

WATER RESOURCES DEPT

SALEM, OREGON

SALEM, OREGON

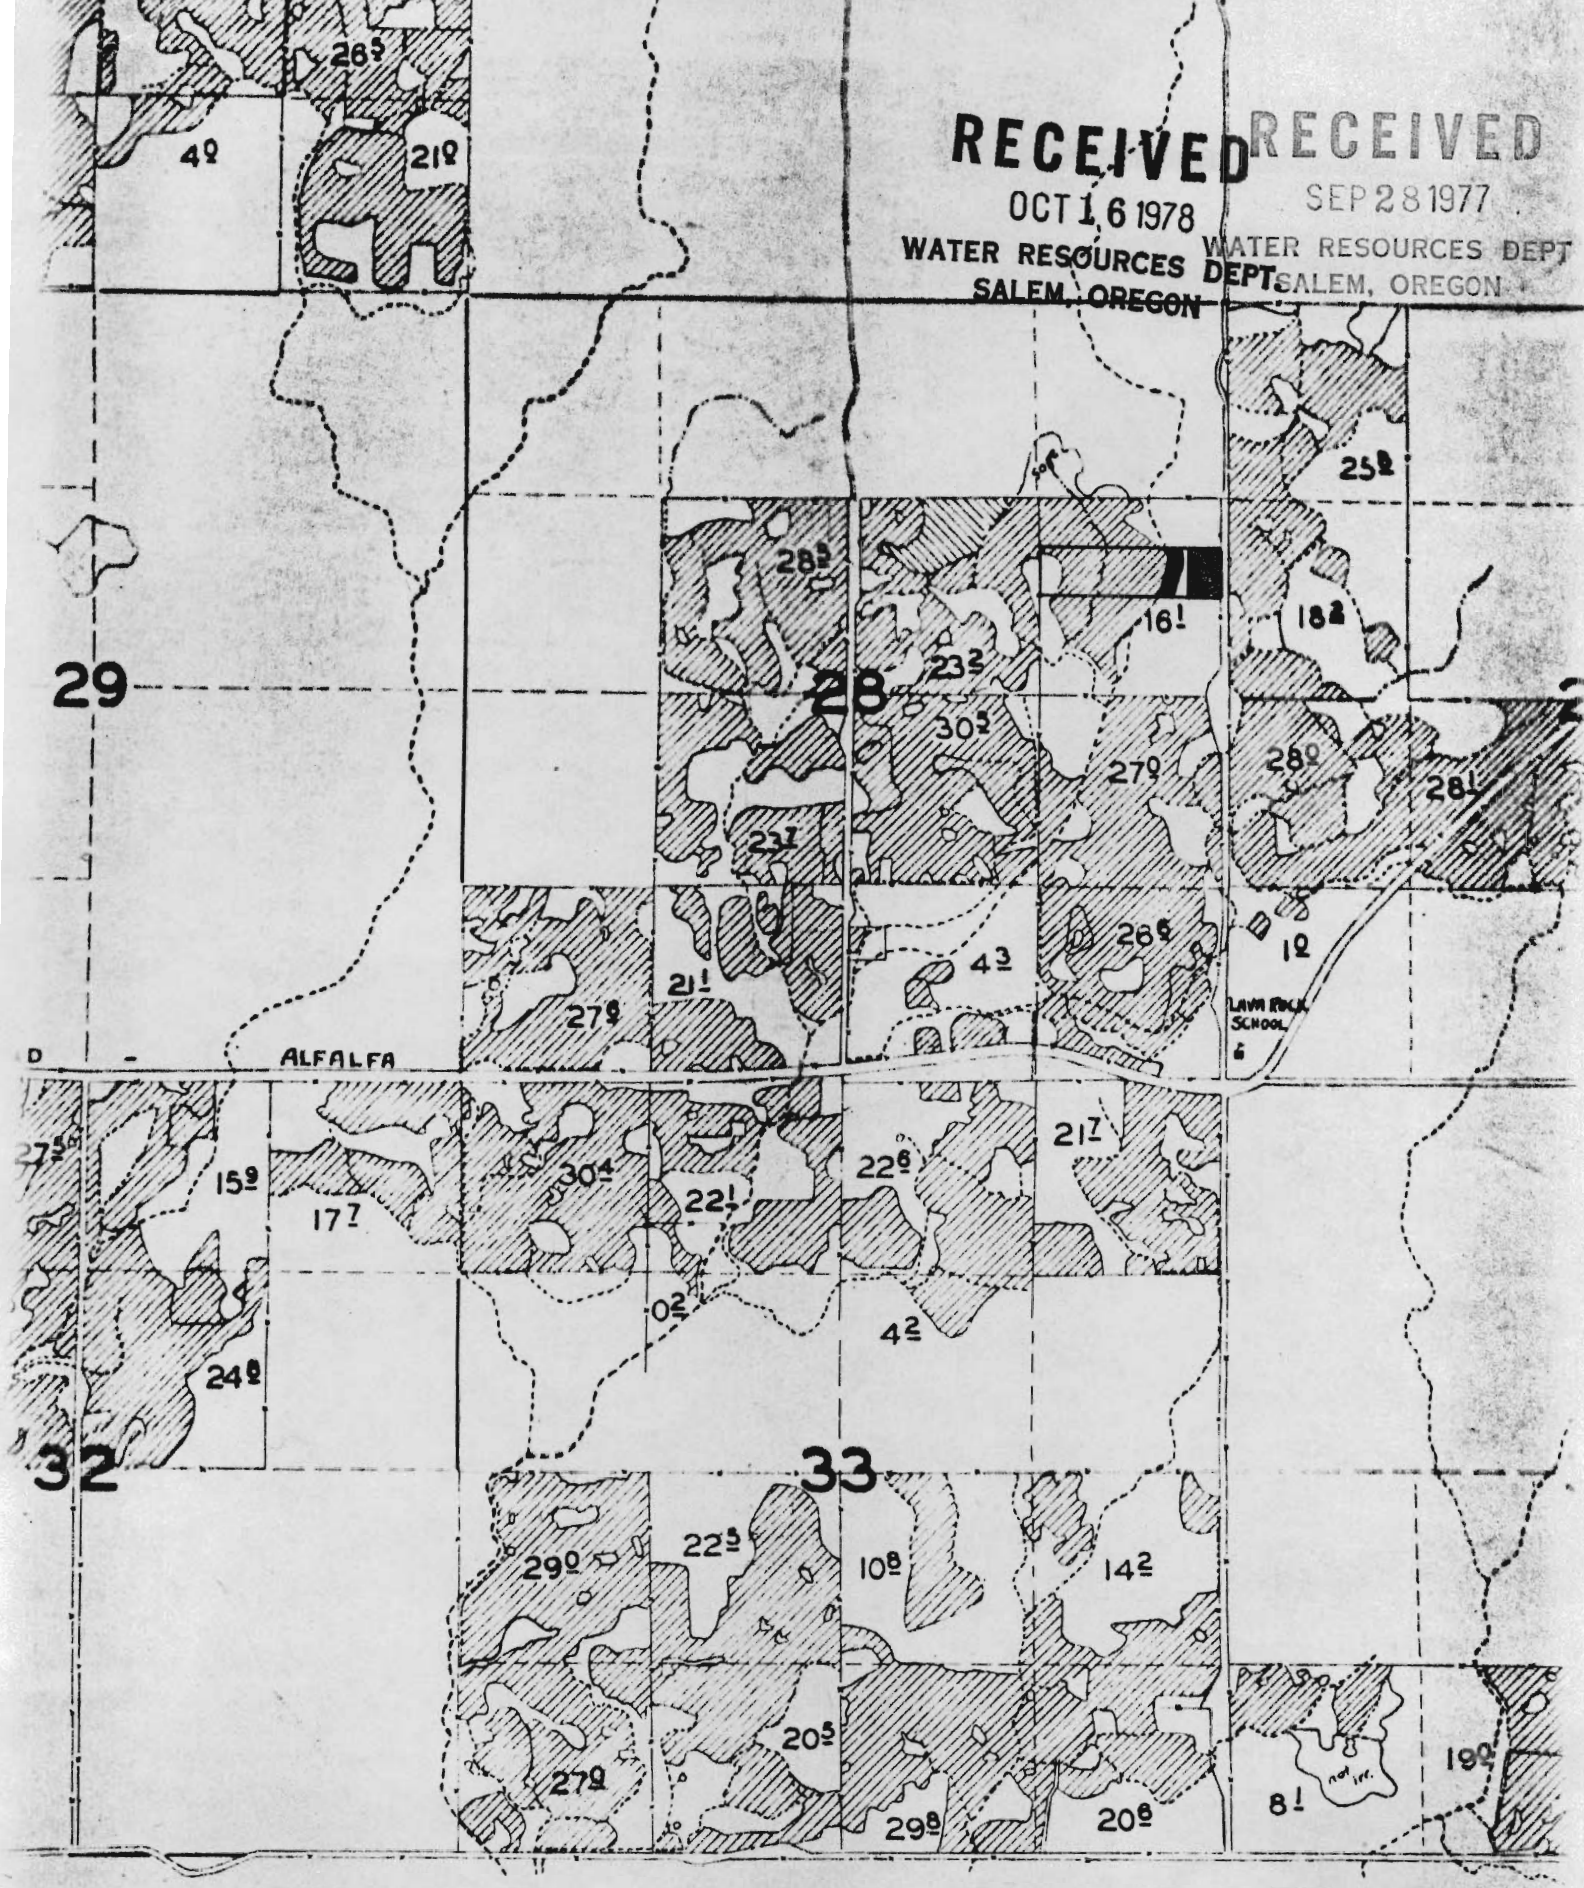

49

269

219

29

289

28

239

309

231

161

259

189

289

281

279

269

19

211

43

279

ALFALFA

LIVIN ROCK SCHOOL

D

279

159

171

304

221

229

211

249

09

42

32

33

299

229

109

142

279

209

299

209

81

199

SECTION 4 T18S. R13E.W.M.  
DESCHUTES COUNTY

Head Number 607

18 13 4

1"=400'

RECEIVED

SEP 28 1977


WATER RESOURCES DEPT  
SALEM, OREGON

RECEIVED

OCT 16 1978

WATER RESOURCES DEPT.  
SALEM, OREGON

See Map 17 13

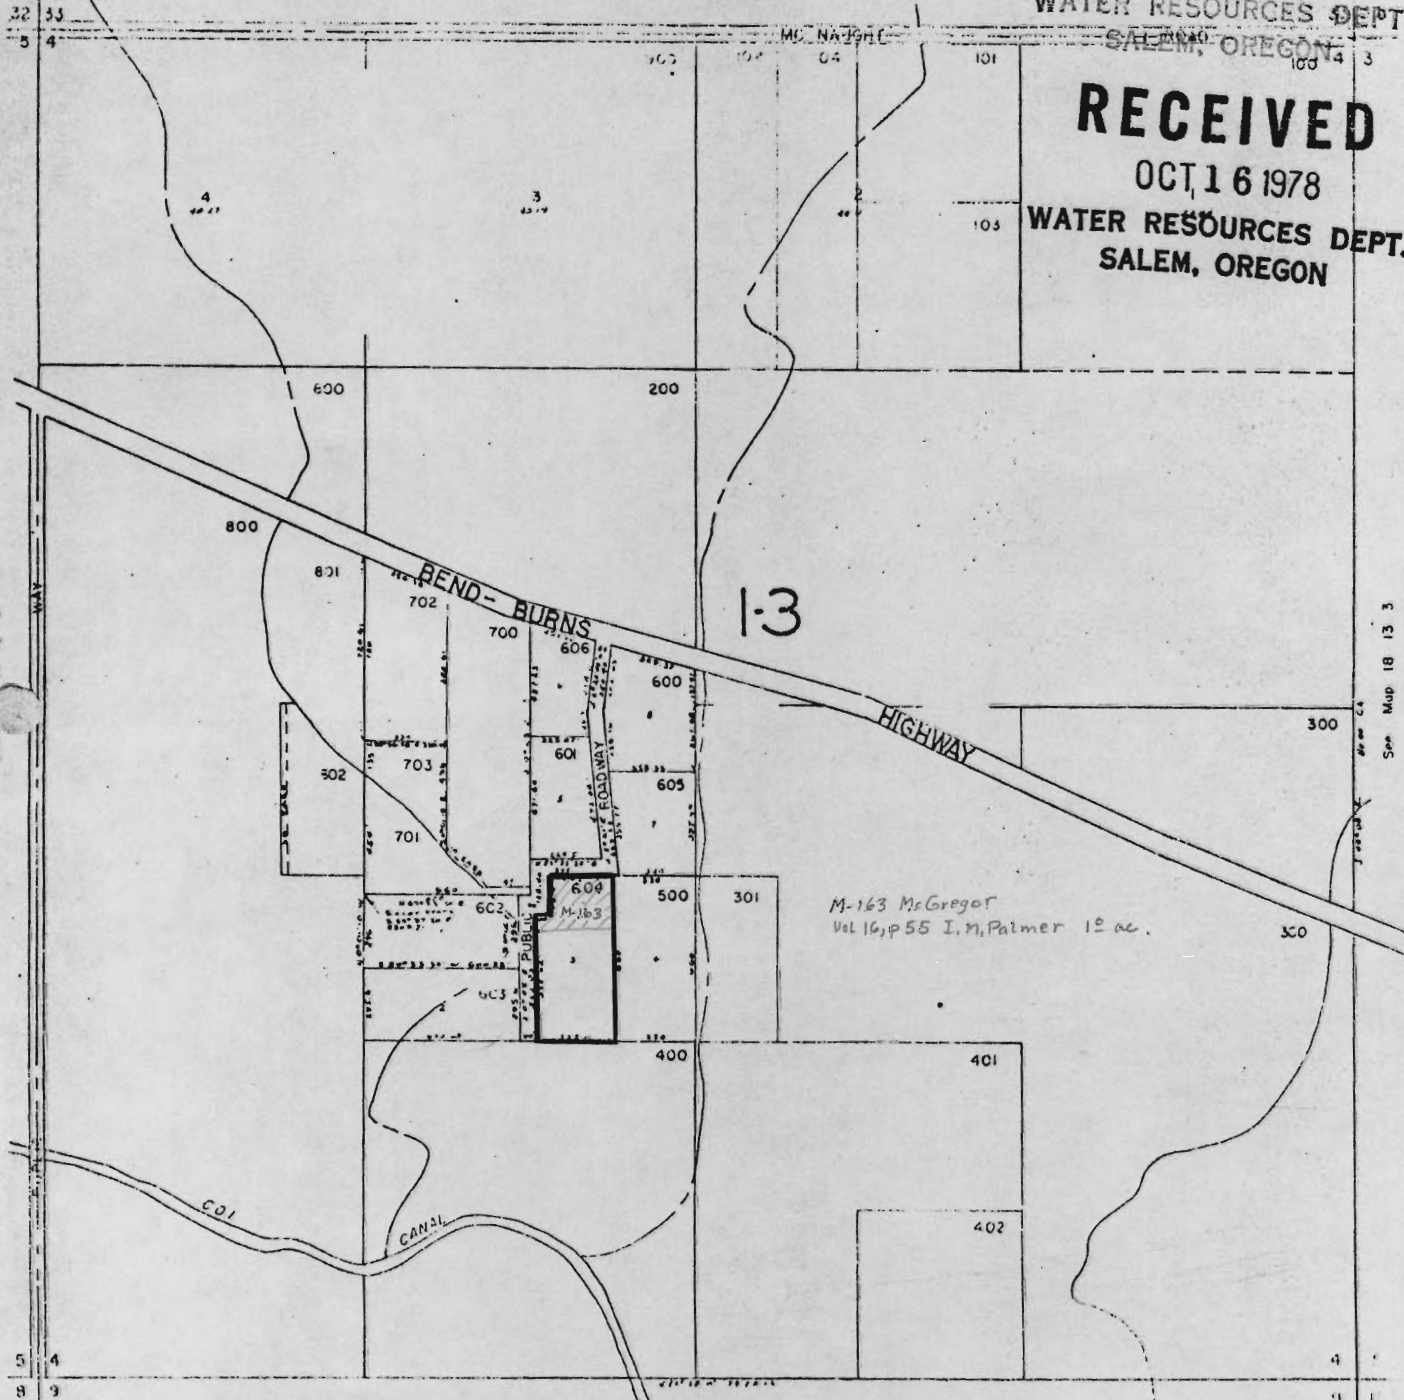

1-3

M-163 McGregor  
Vol 16, p 55 I, M, Palmer 1 1/2 ac.

See Map 19 13 9

18 13 4