


T.17 S., R.13 E., W.M.

SEC. 32

SW 1/4 NW 1/4

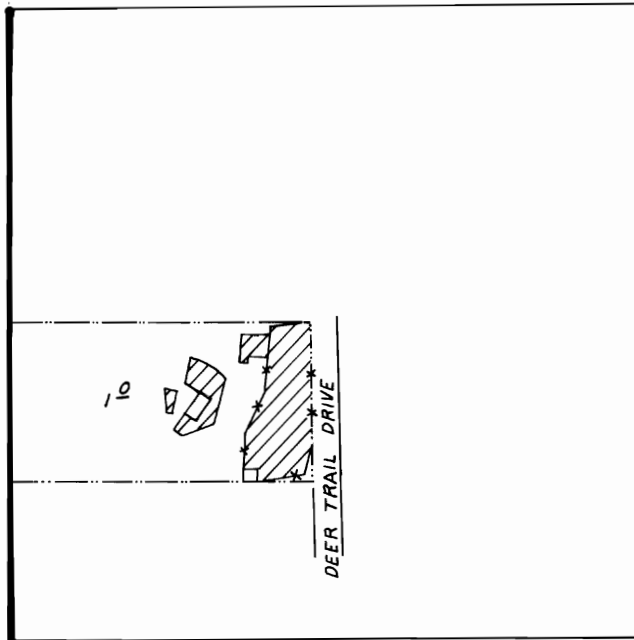

SCALE: 1" = 400'

FINAL PROOF SURVEY

UNDER

PART OF

TRANSFER 3807

Application No. Permit No.

IN NAME OF

..... DAN GREEN, JR. / COID

Surveyed AUG. 14... 19.84, by LESLIE OLSON....