



T 17 S, R 13 E

RECEIVED

SEP 28 1977

WATER RESOURCES DEPT
SALEM, OREGON

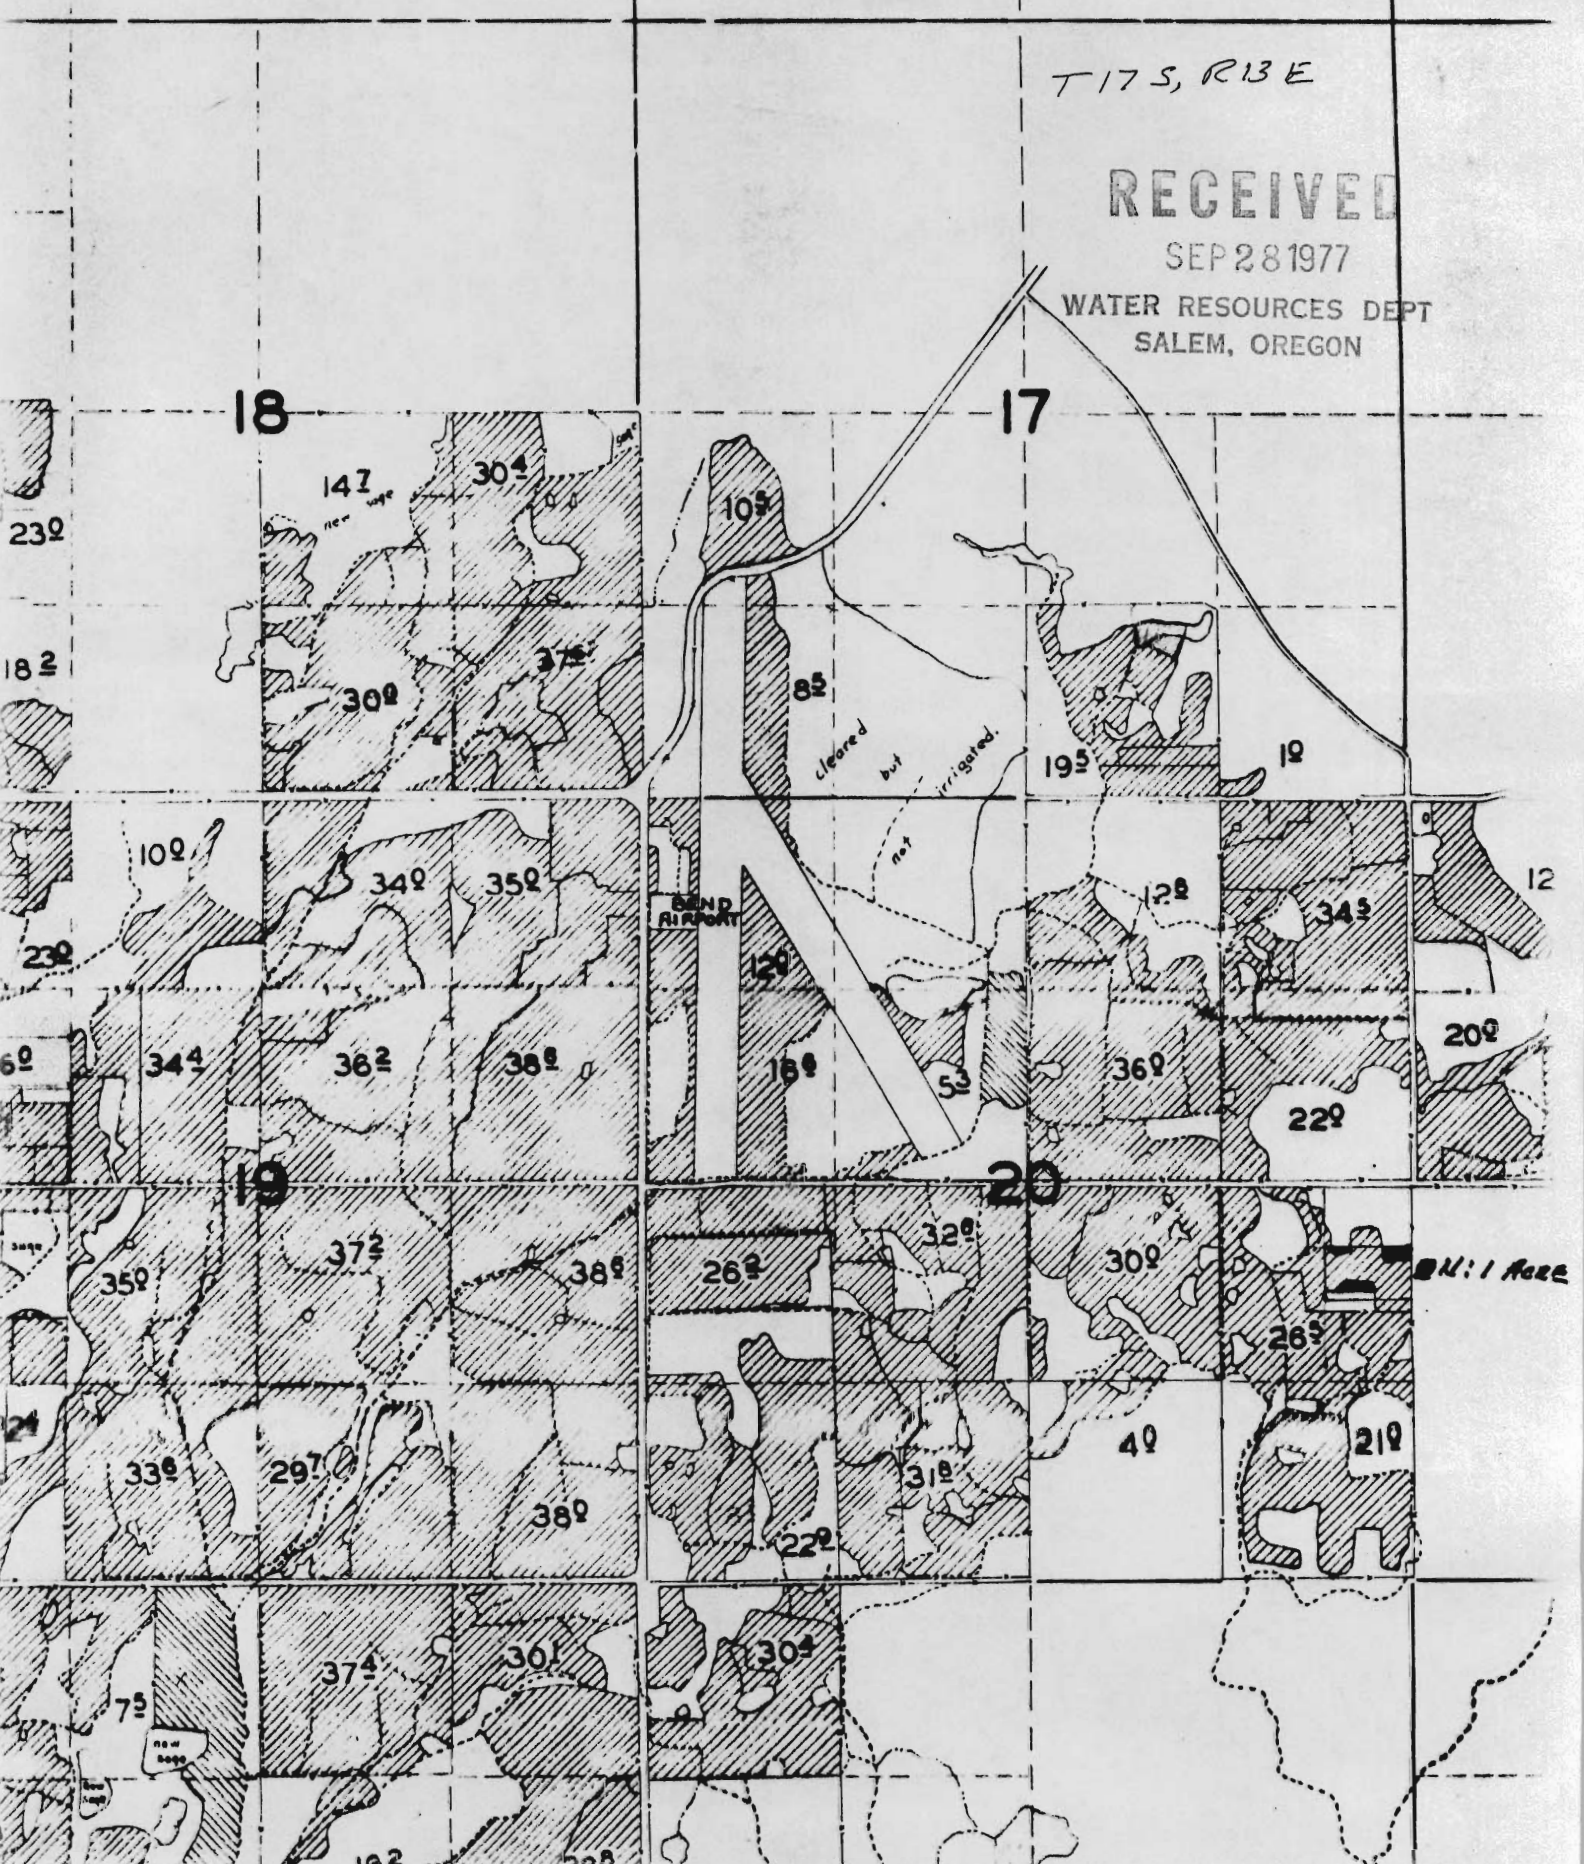

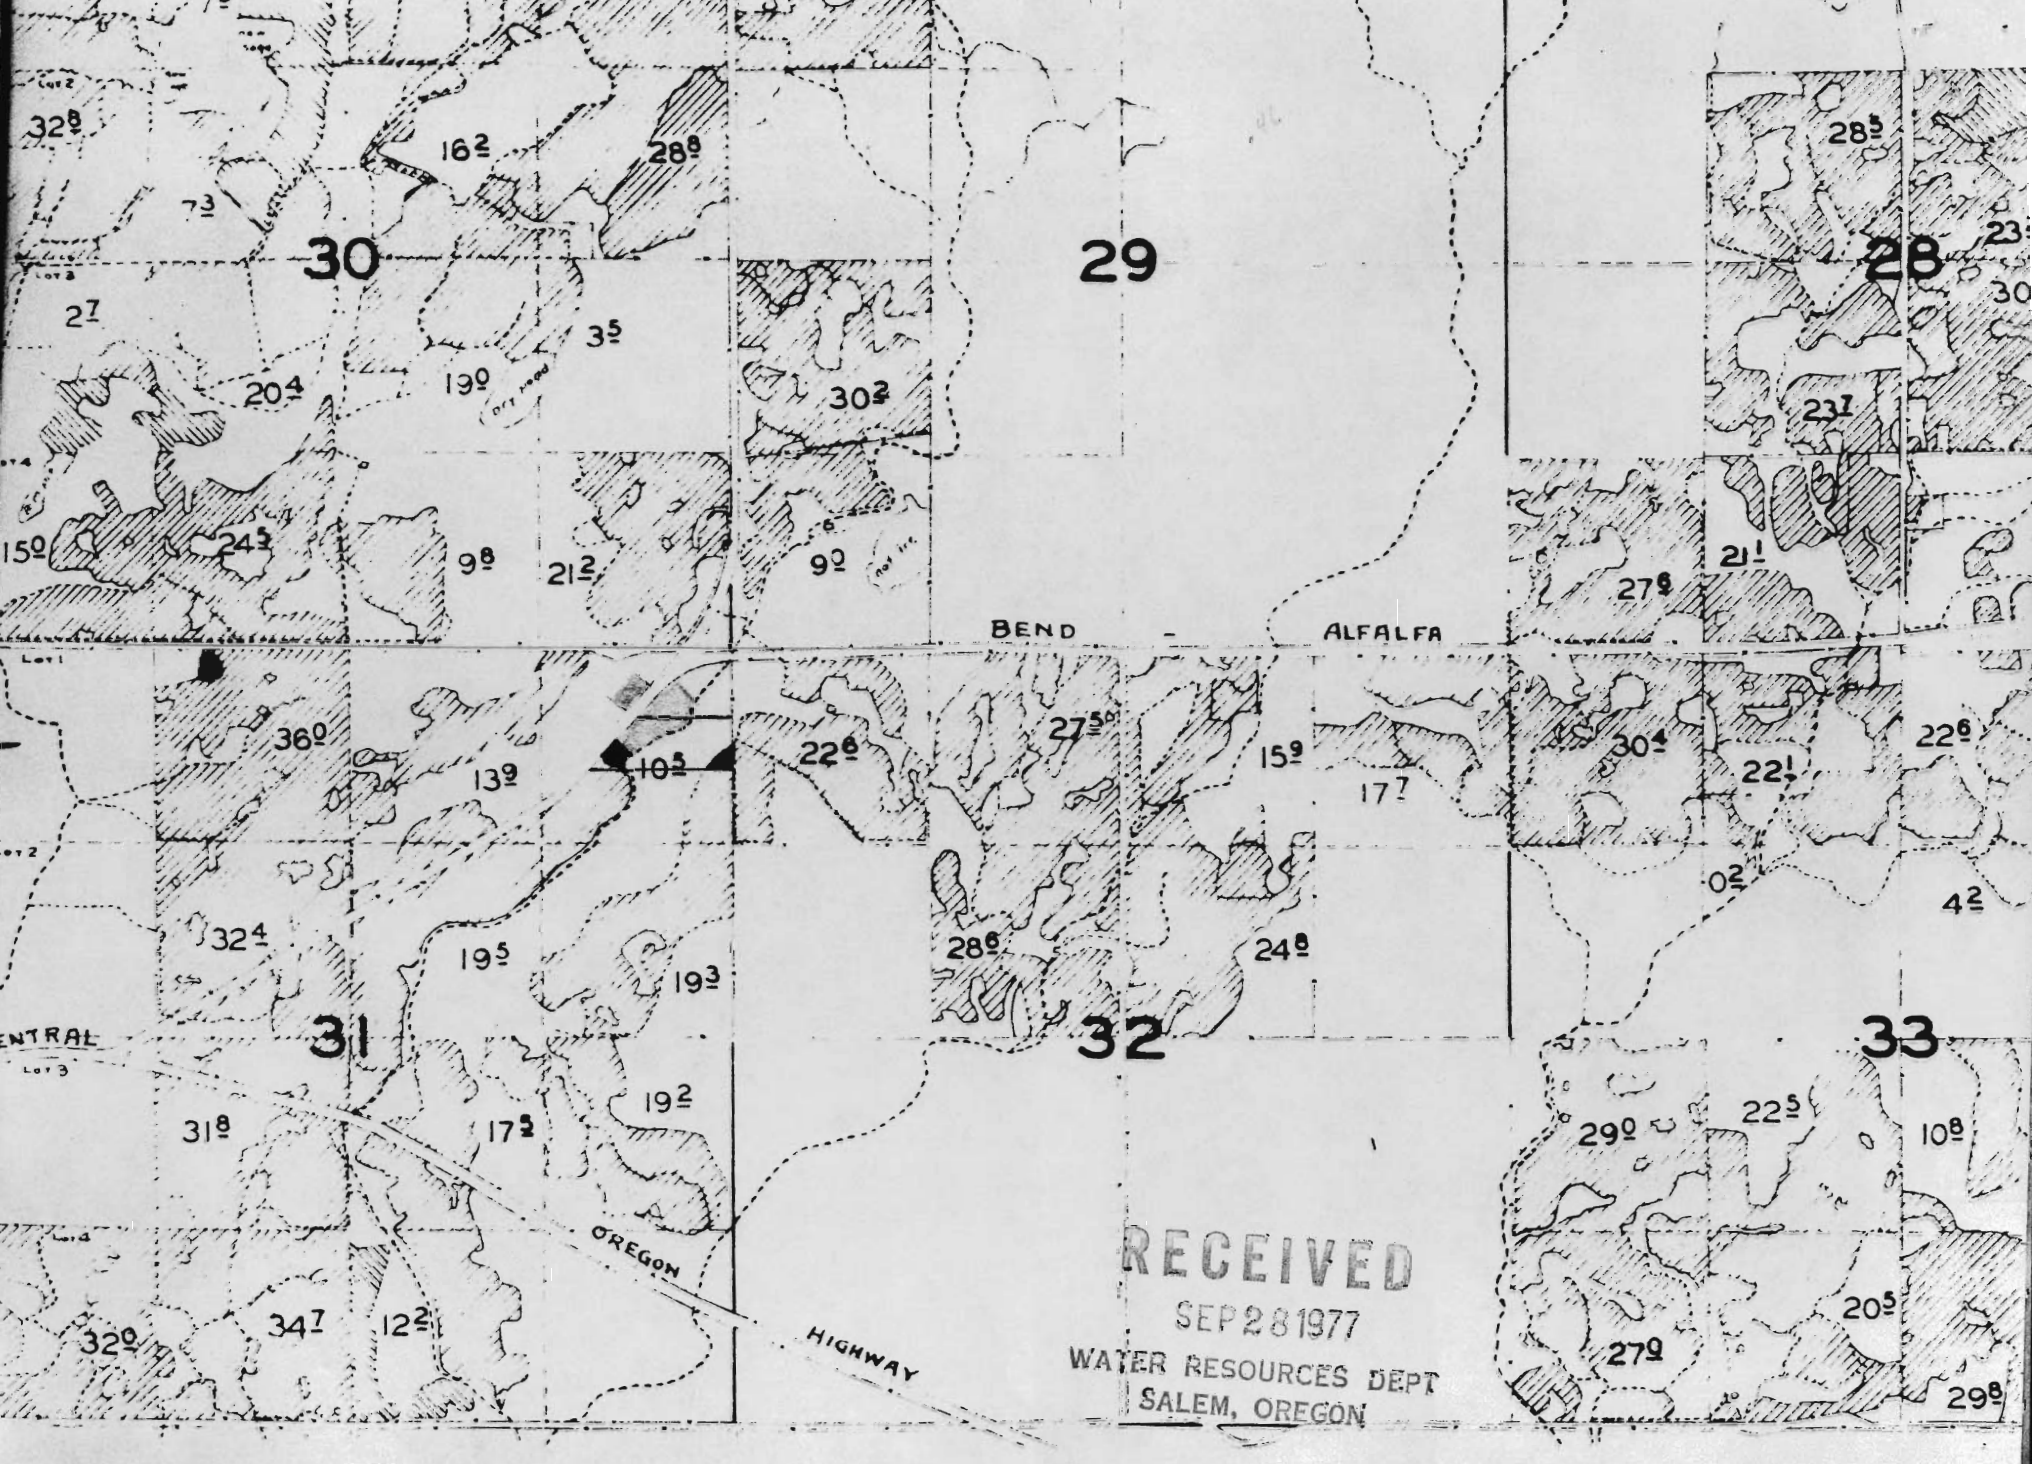

RECEIVED
SEP 28 1977
WATER RESOURCES DEPT
SALEM, OREGON