


T. 35 S., R. 1 W., W.M.

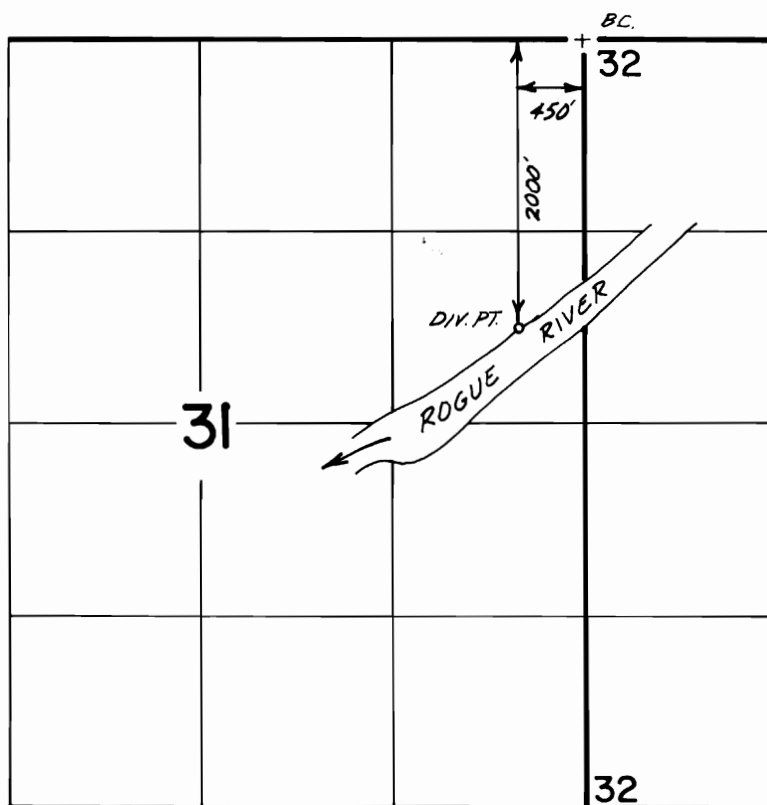

Scale 1"=1320'

FINAL PROOF SURVEY
UNDER

Transfer No. 3810

Application No. Permit No.
IN NAME OF

ROBERT J. & JANICE S. MORRIS

Surveyed Nov. 19 1985, by B.S. JAMES