


T. 35S., R. 1W., W.M.

Sec. 31

SE 1/4 NE 1/4

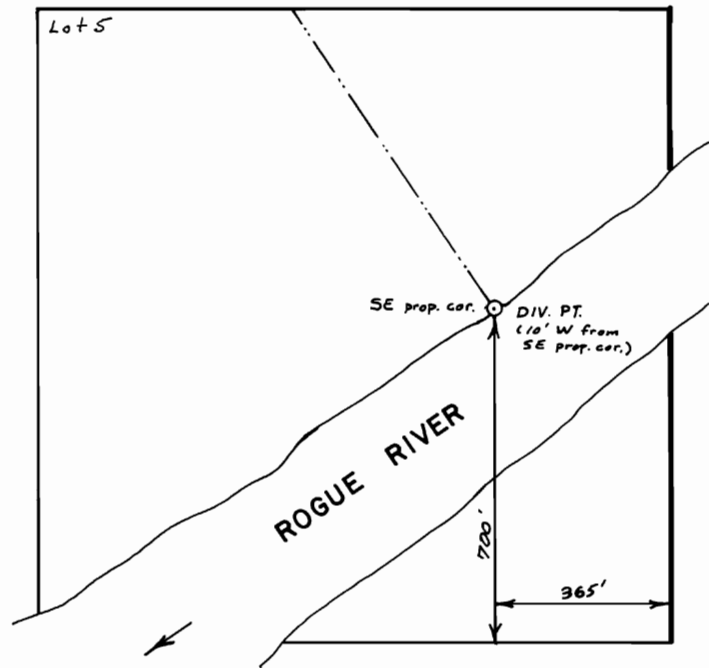

Scale 1"=400'

FINAL PROOF SURVEY

UNDER

Transfer no. 3811

Application No. Permit No.

IN NAME OF

MARILYN M. & WILLIAM J. DOLAN Jr.

Surveyed Dec. 7, 1979, by B.R. SUND