


T. 6S. R. 1E., W.M.

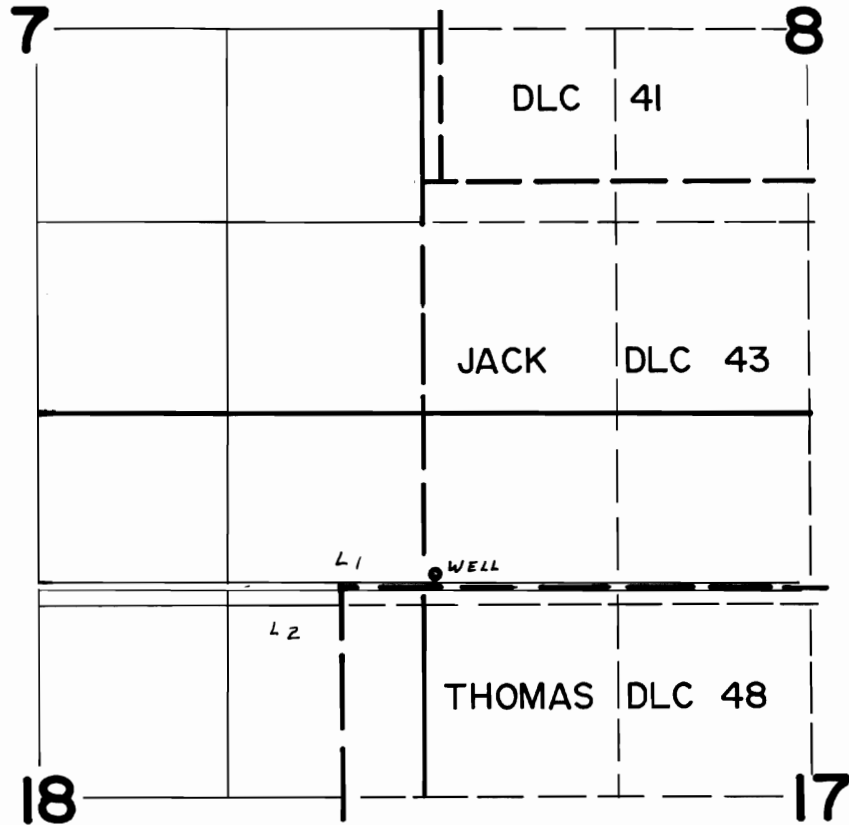

Well Loc. 1110' S. & 80' E. From N.W. Cor. Sec. 17

FINAL PROOF SURVEY UNDER

Transfer No. 3814
Application No. Permit No.
IN NAME OF

..... HAROLD KRAEMER

Surveyed JUNE 6, 1979, by L.H. NUNN