


# T.18 S., R.12 & 13 E., W.M.

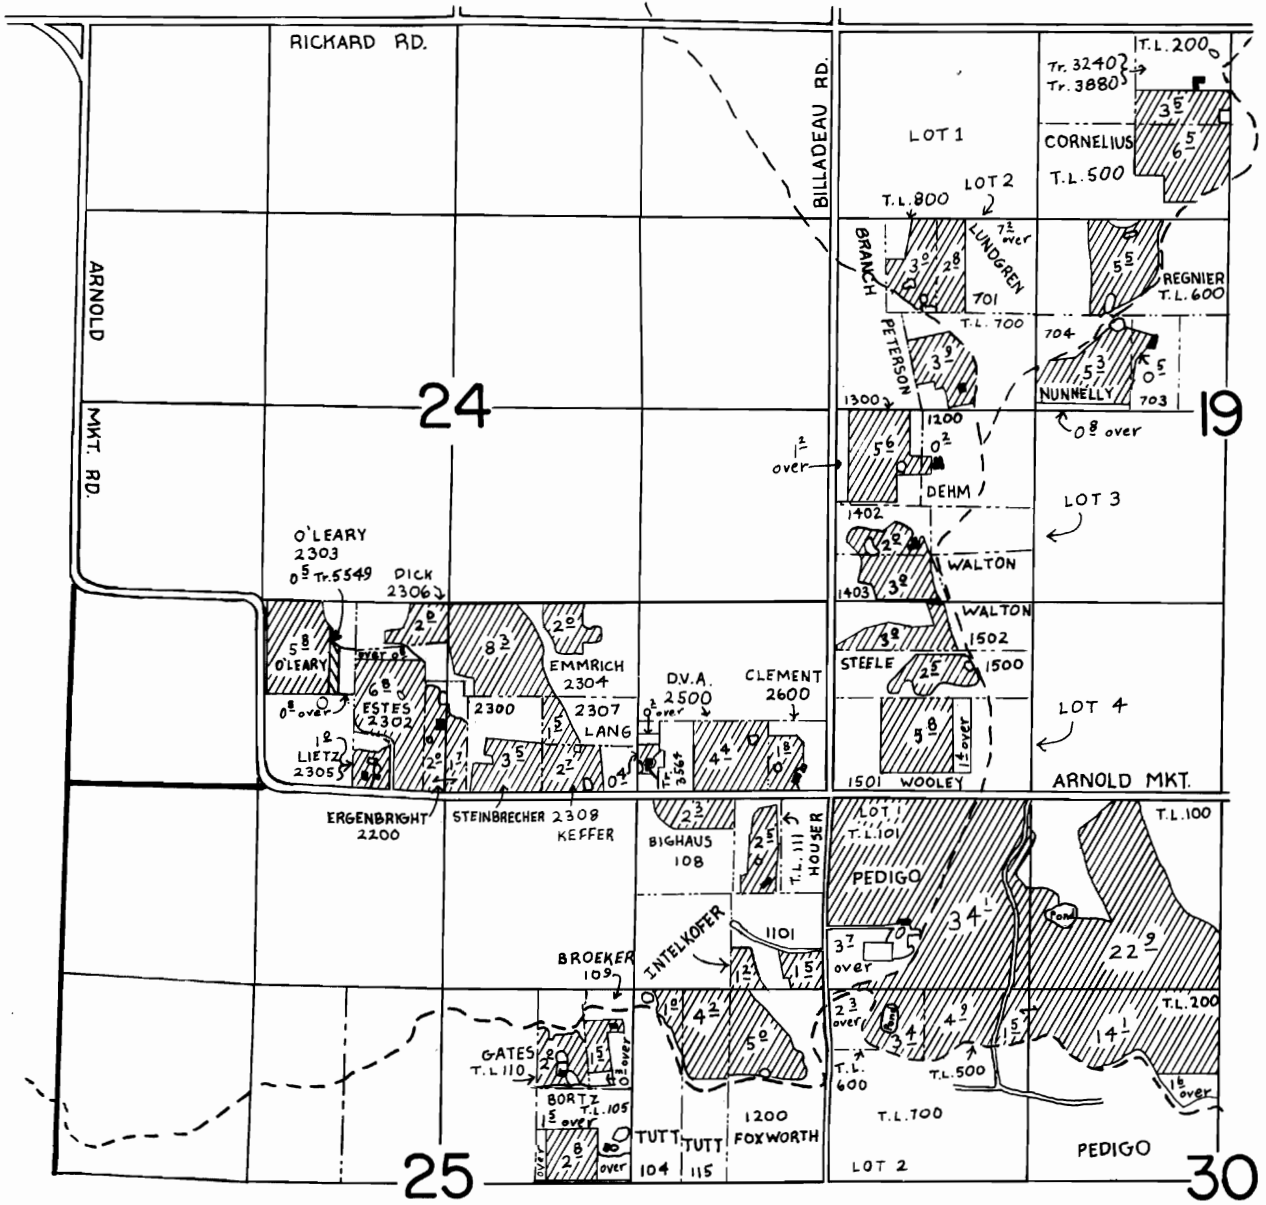

SCALE : 1" = 1320'

## FINAL PROOF SURVEY

UNDER

TRANSFER NO. 5549

PART OF TRANSFER NO. 3815

IN NAME OF

**A.I.D. VARIOUS USERS**

Surveyed MAR. 29. 1985., by L.G. OLSON.....  
thru APRIL 28, 1987 and M.J. MATTICK

