
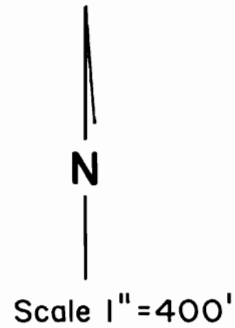
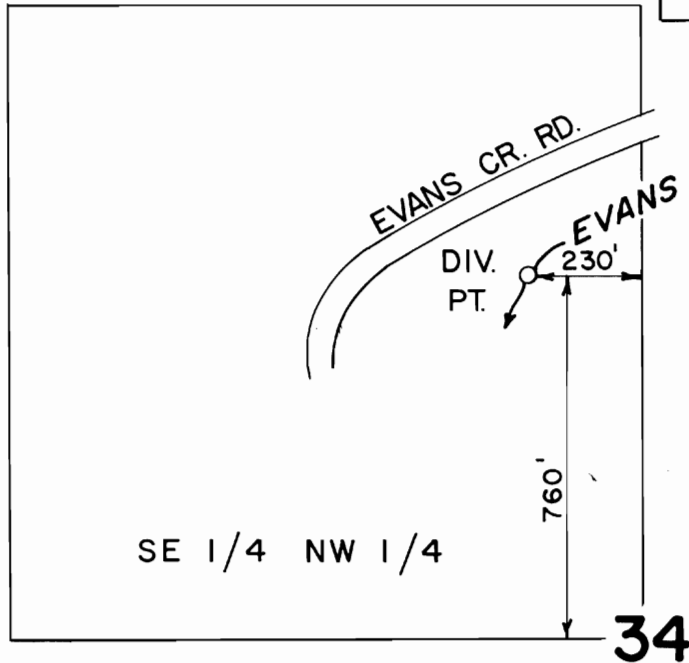


T. 34S., R. 3 W., W.M.

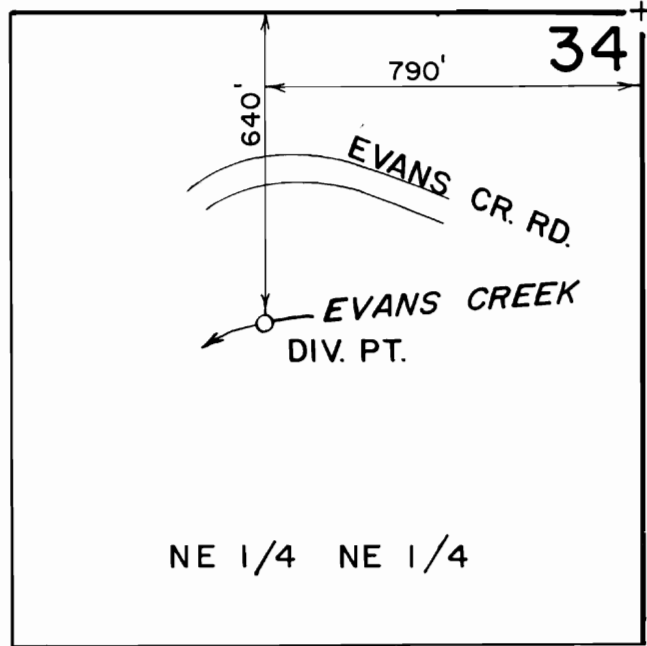

**FINAL PROOF SURVEY**  
UNDER

Transfer No. 3822

Application No. \_\_\_\_\_ Permit No. \_\_\_\_\_  
IN NAME OF

STANLEY B. CHRISTIE

Surveyed Sept. 17, 1980, by B.R. SUND  
Sept. 29, 1986 B.S. JAMES