


# T. 36 S., R. 1 W., W. M.

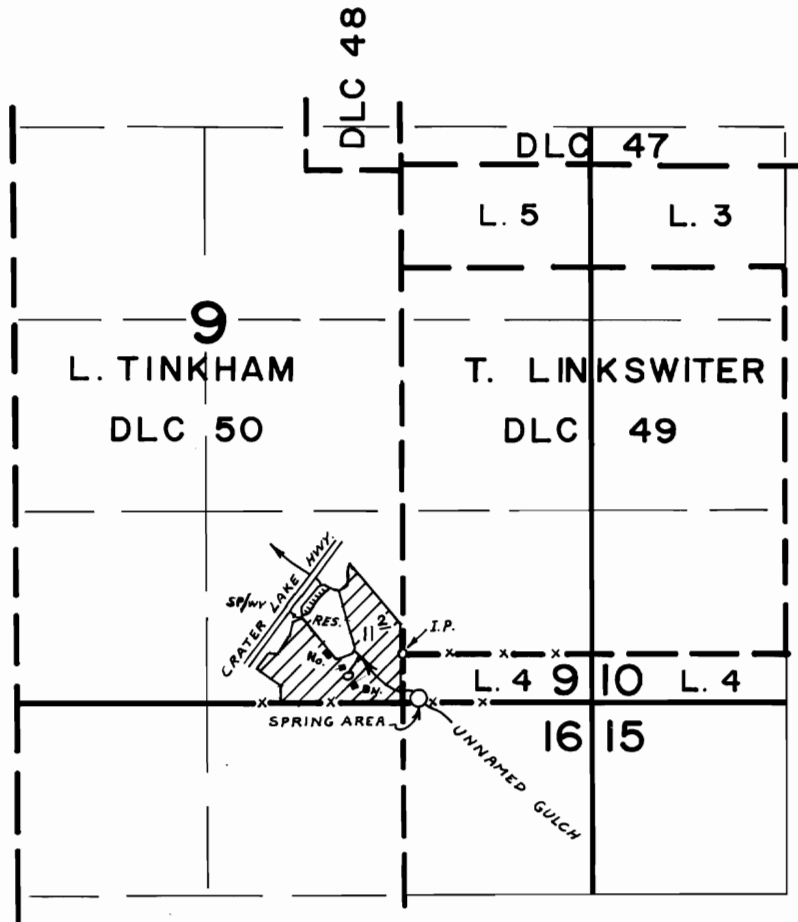

Scale 4" = 1 mile

## FINAL PROOF SURVEY UNDER

TRANSFER NO. 3836

Application No. \_\_\_\_\_ Permit No. \_\_\_\_\_  
IN NAME OF

DAVID L. & ADELE STAR HARRINGTON & ROSIE MAYES

Surveyed DEC. 13, 1979, by B. SUND