


T.13S. R.12E. W.M.

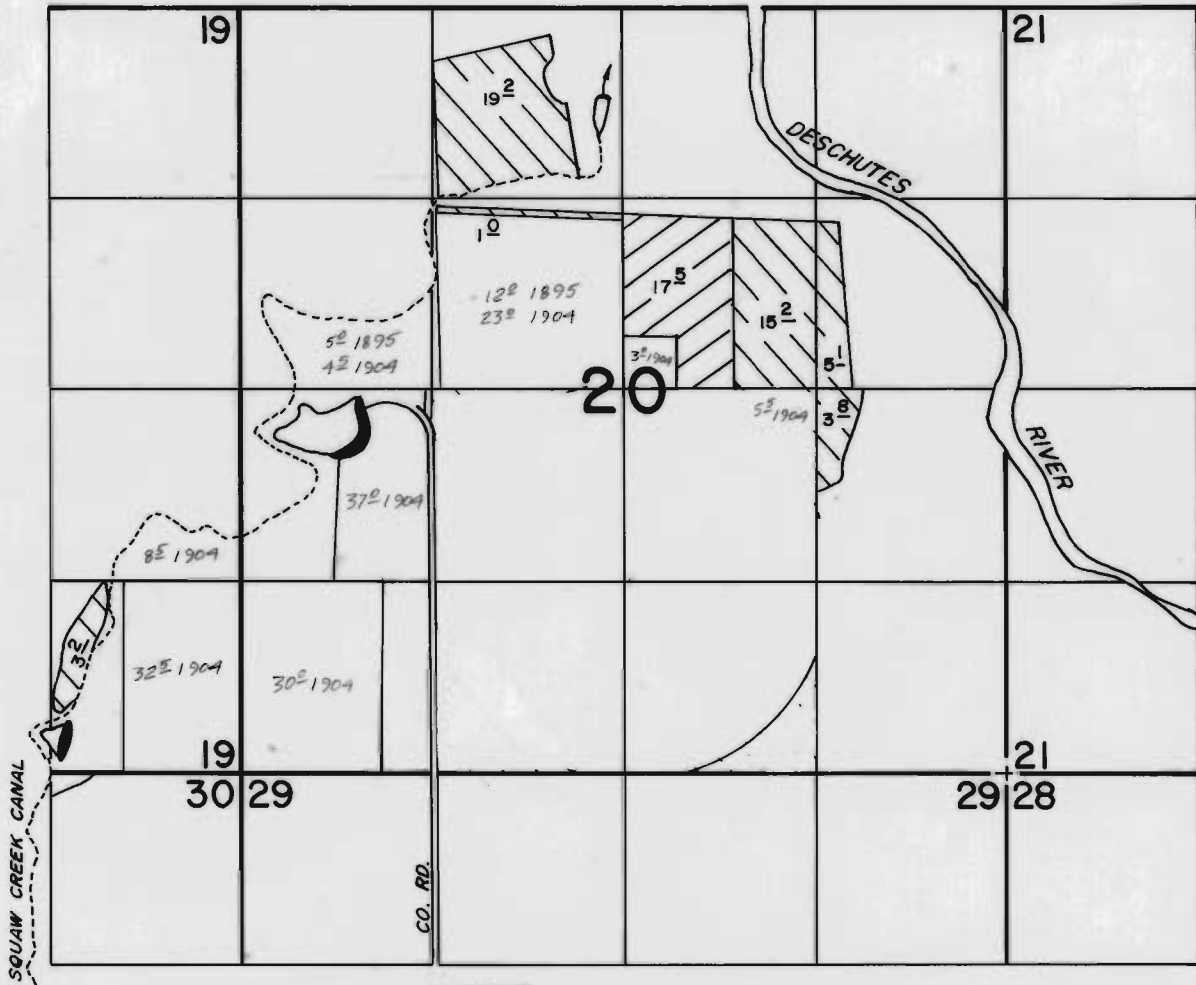

T 2496

T 3837

FINAL PROOF SURVEY UNDER

TRANSFERS NO. 2496 & 3837

Application No. Permit No.

IN NAME OF

GLENN L. COOPER

Surveyed **MAY 8** 1980, by **L.H. NUNN**