


T. 9S., R. 40E., W.M.

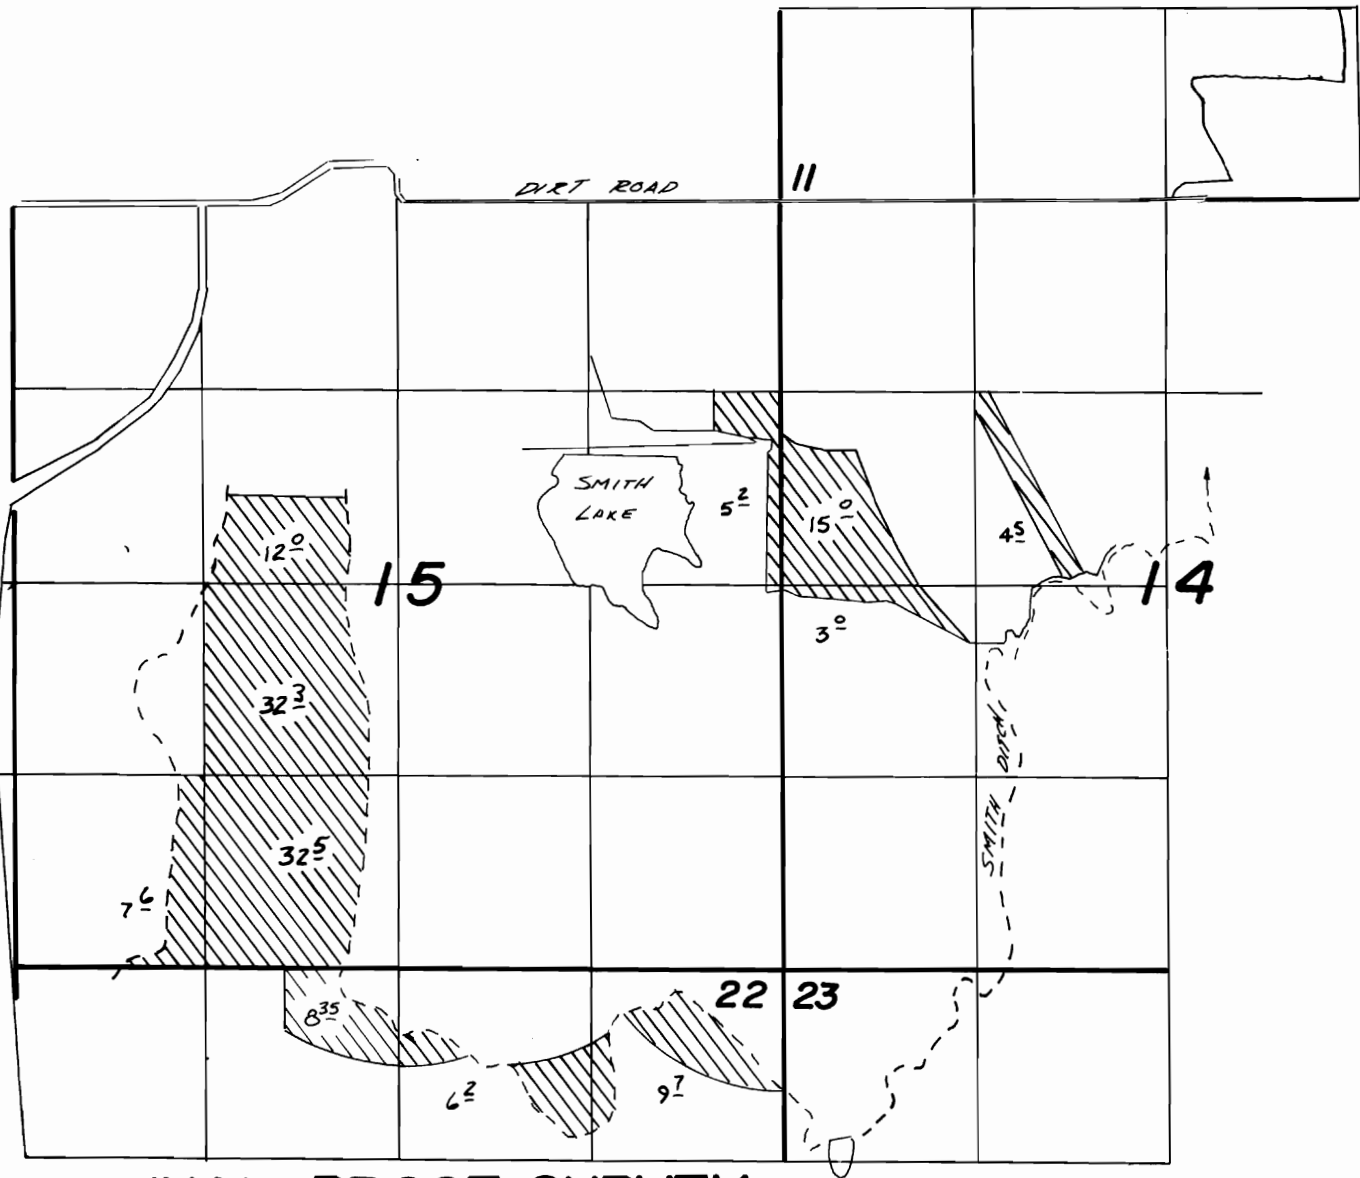

FINAL PROOF SURVEY
UNDER

TRANSFER 3840
IN NAME OF

JOHN BOOTSMA

SURVEYED Aug. 5 1981, BY J.L. Church

T. 10S., R. 40E., W.M.

