


T. 28 S. R. 6 W. W.M.

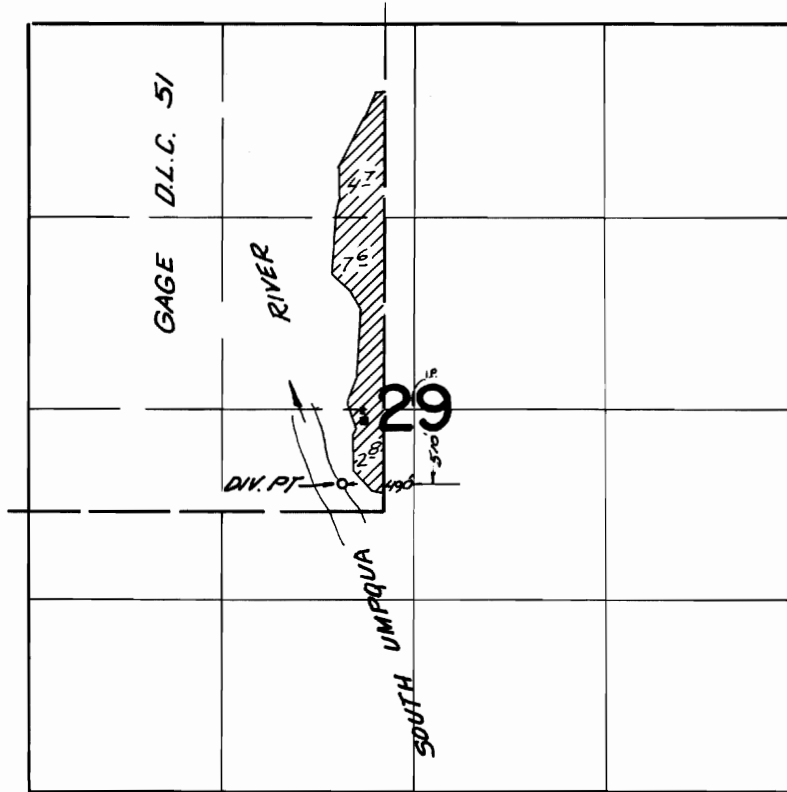

FINAL PROOF SURVEY
UNDER

Application No. 33706 Permit No. 26640
IN NAME OF

PAUL B. HULT LUMBER Co.

Surveyed *April 16* 1967, by *V. Garner*