


T.12S.,R.1W.,W.M.

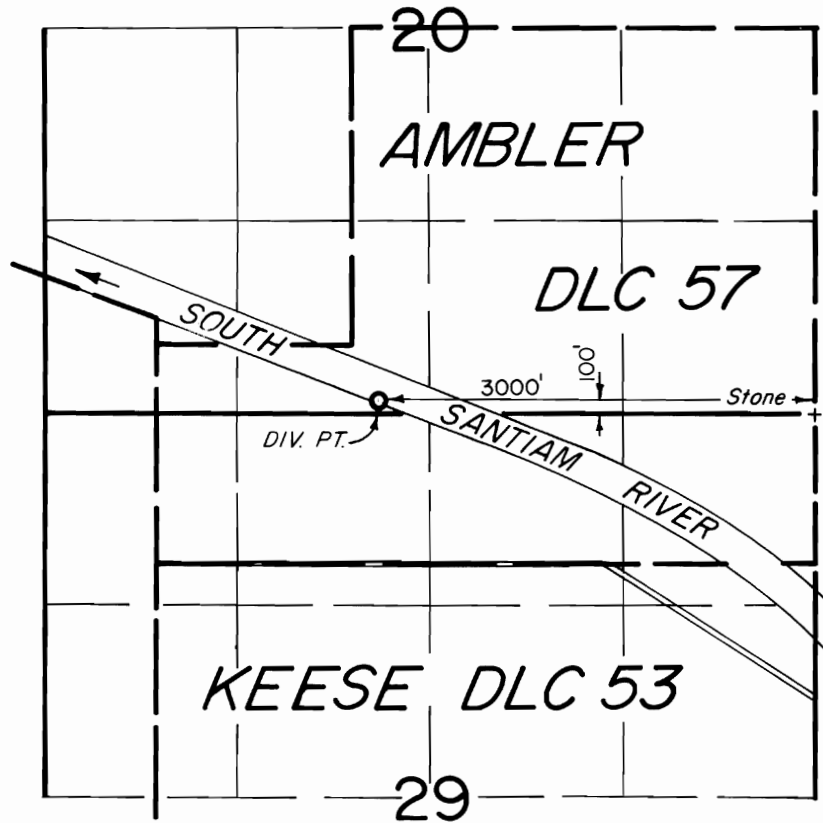

FINAL PROOF SURVEY
UNDER

TRANSFER NO. 3845

IN NAME OF

Henry A. Gonseth

Surveyed MAY 2, 1979, by *M. Brown*