


T.30S., R.5W., W. M.

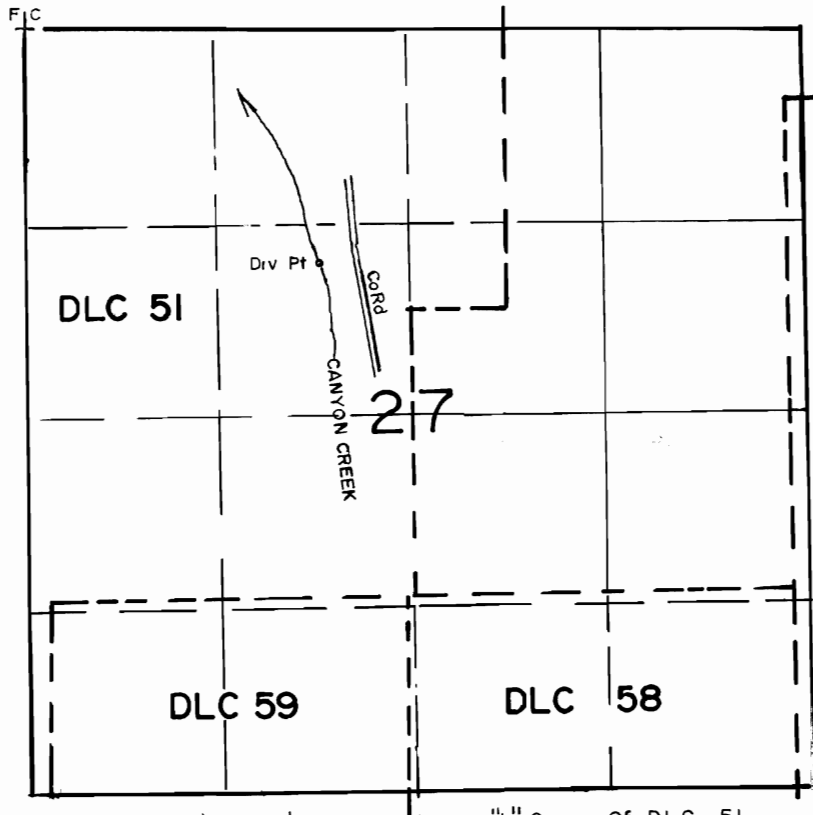

Div Pt Located 350' N & 600' W From The Interior "L" Corner Of DLC 51

SCALE: 1" = 1320'

**FINAL PROOF SURVEY  
UNDER**

TRANSFER NO 3852

Application No. .... Permit No. ....  
**IN NAME OF**

..... **Keith** ..... **McGinnis** .....

Surveyed APRIL 17 1990., by B.S. JAMES.....