


T.1S., R.48E., W.M.

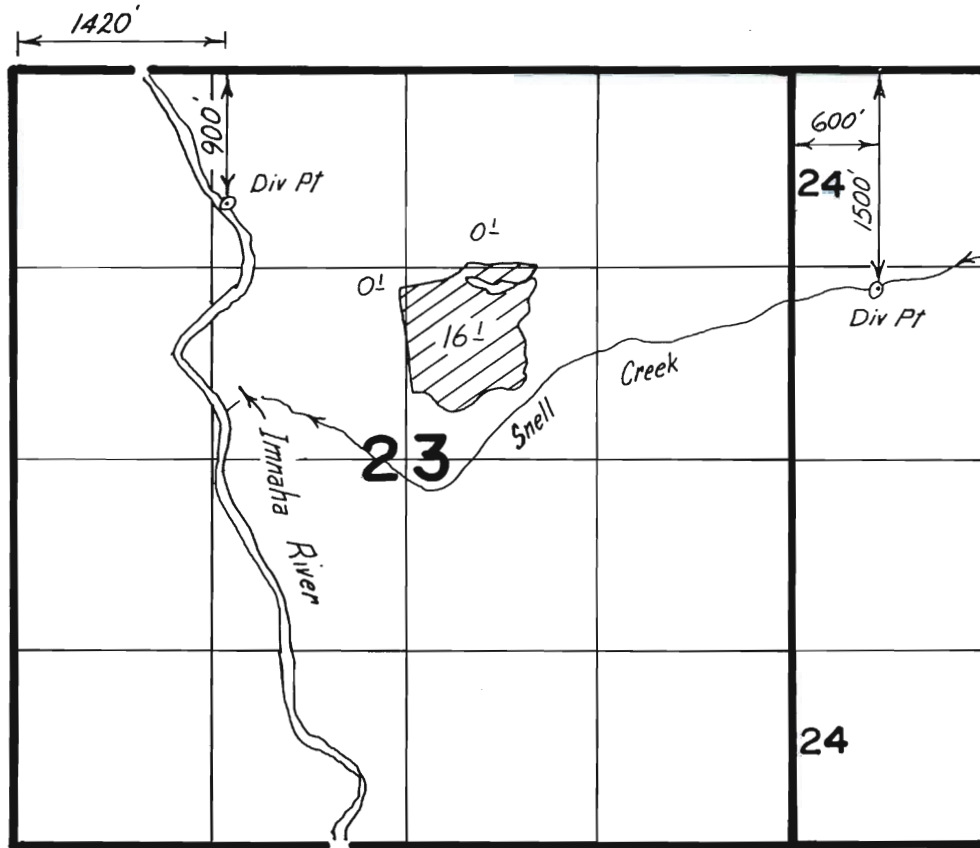

FINAL PROOF SURVEY

UNDER

TRANSFERS **3857**
4317

Scale: 1" = 1320'

IN NAME OF

GRANT T. WARNOCK

Surveyed 10-28, 1988, by Vern Church.