


T.9S., R.2W., W.M.

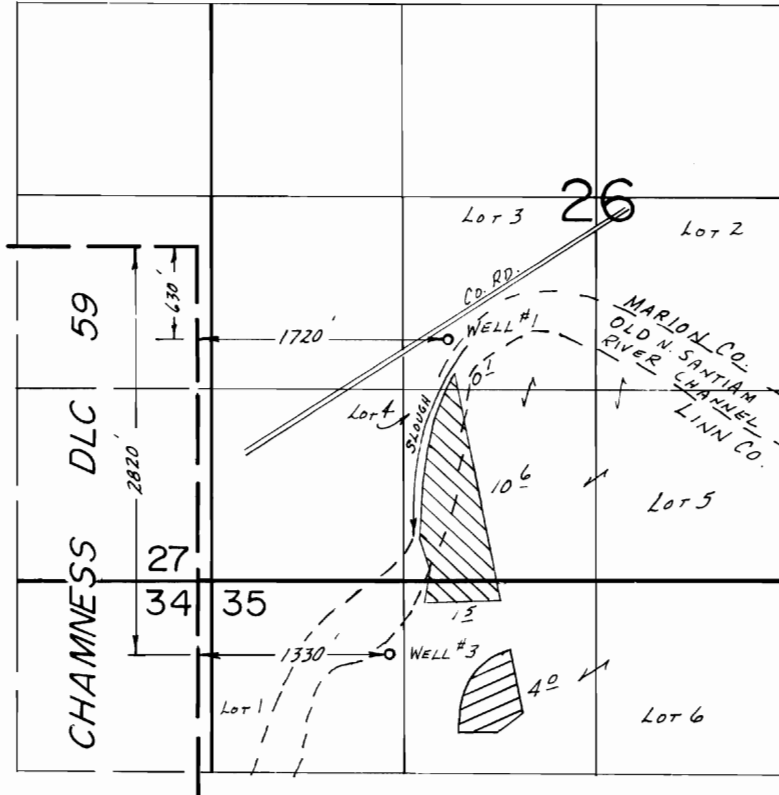

-  Well No. 1
-  Well No. 3

SCALE: 1"=1320'

FINAL PROOF SURVEY UNDER

Transfer No. 3858

IN NAME OF

.....DENNIS E. & ANNE KOENIG.....

Surveyed May 17, 1985, by T.M. WARREN....