


T. 1 S. R. 9 & 10 E. W.M.

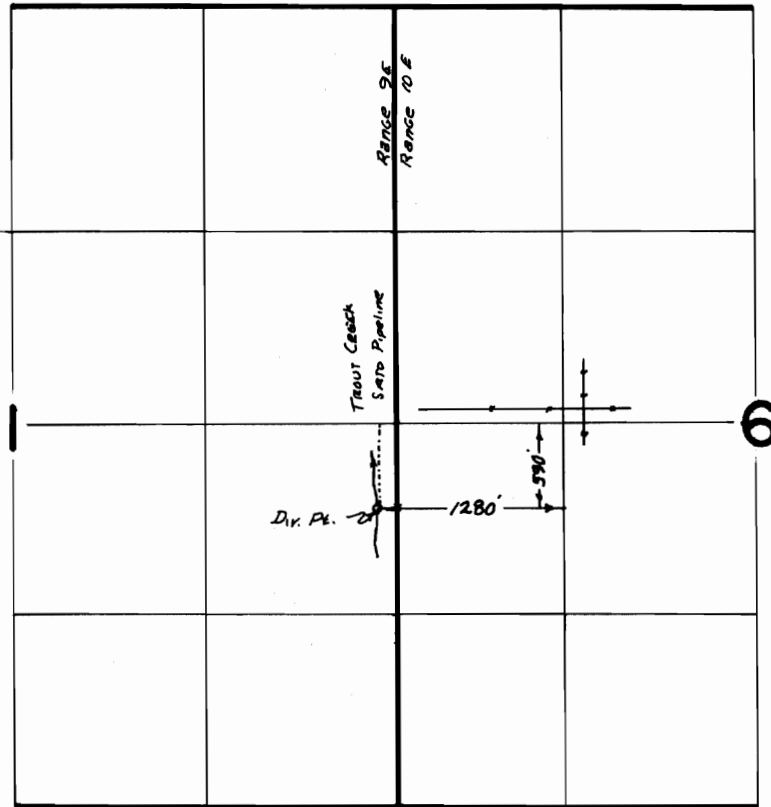

**FINAL PROOF SURVEY**  
UNDER

Transfer No. 2763  
Application No. \_\_\_\_\_ Permit No. \_\_\_\_\_  
IN NAME OF

**MIDDLE FORK IRRIGATION DISTRICT**

Surveyed DEC. 22. 1977, by T. PAUL

T-3866