
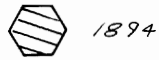
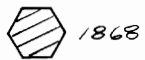


T. 8S., R. 38E., W.M.

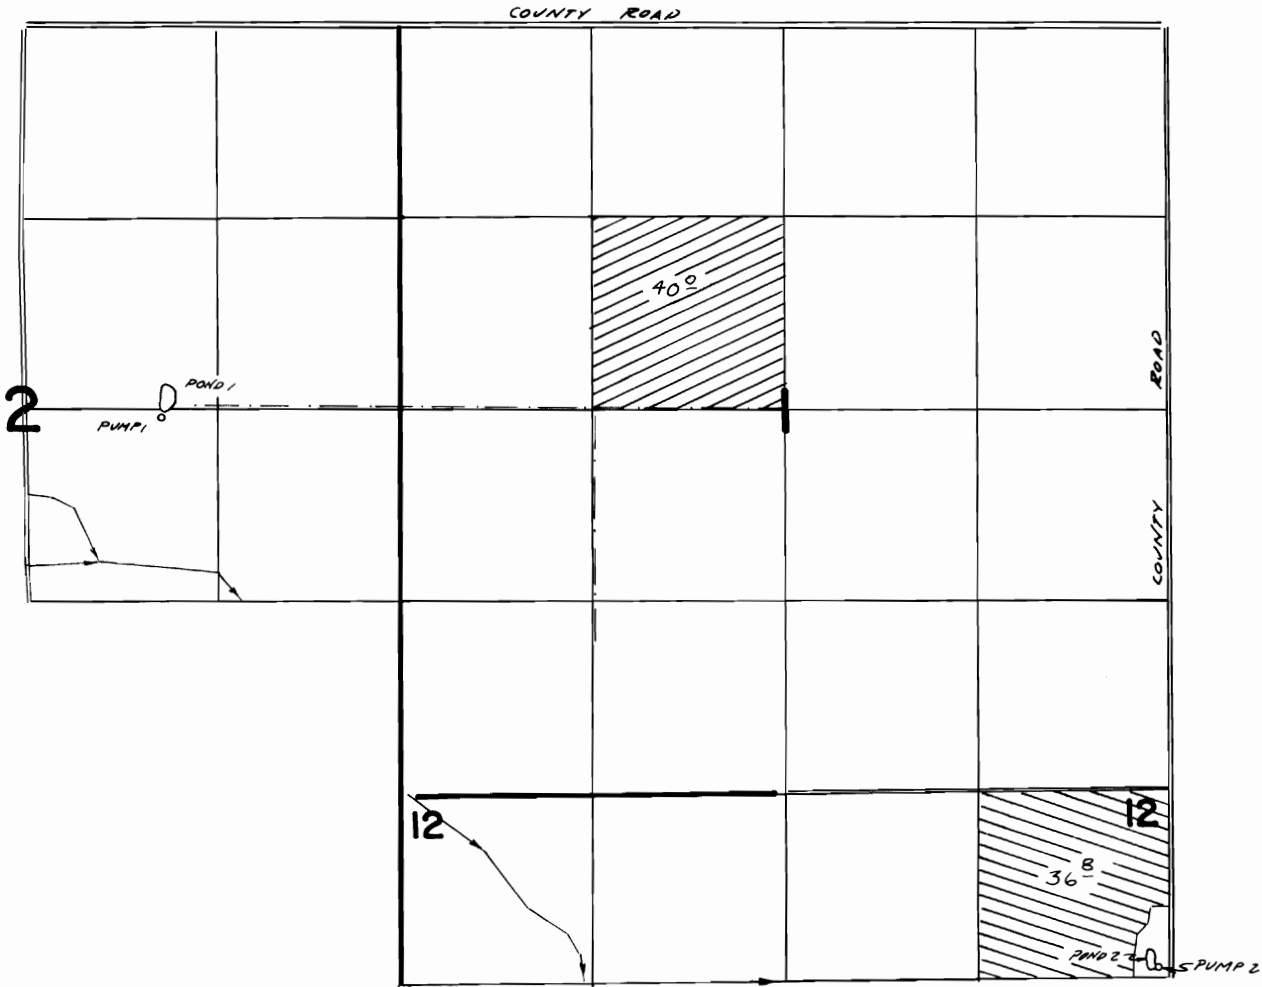

FINAL PROOF SURVEY
UNDER

TRANSFER 3868

IN NAME OF

TIM L. KERNS

Surveyed 4-12-1982, by *Vernan L. Church*