


T. 6N., R. 34E., W. M.

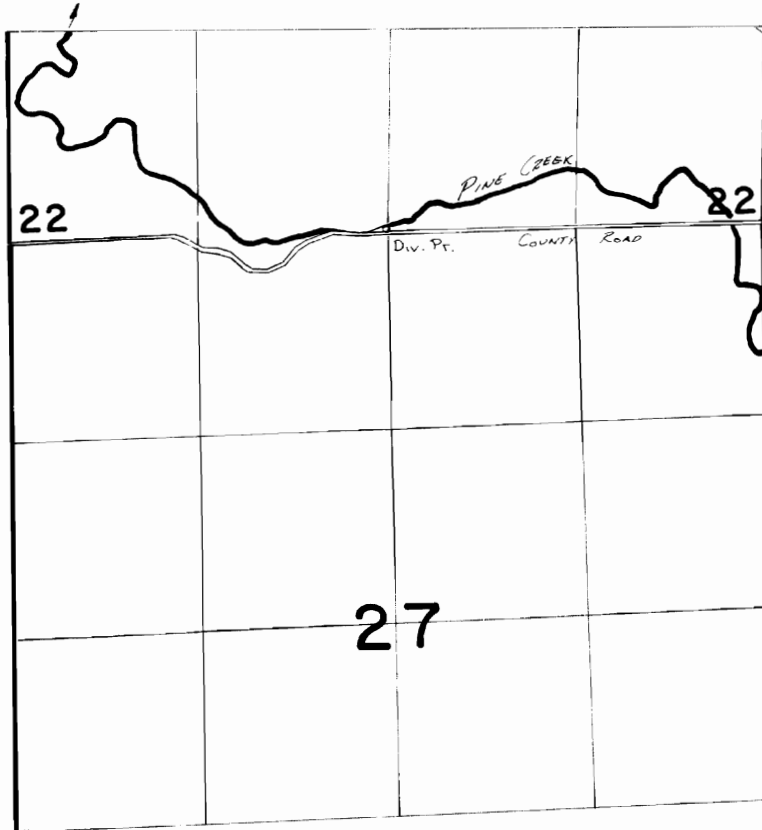

Div. Pt. LOCATED 30' N. & 20' W. FROM S 1/4 COR. SEC 22

FINAL PROOF SURVEY
UNDER

TRANSFER 3871

IN NAME OF

E. DUANE LEINBACH

Surveyed *Aug. 22*, 19*83*, by *J. L. Chuvpala*