
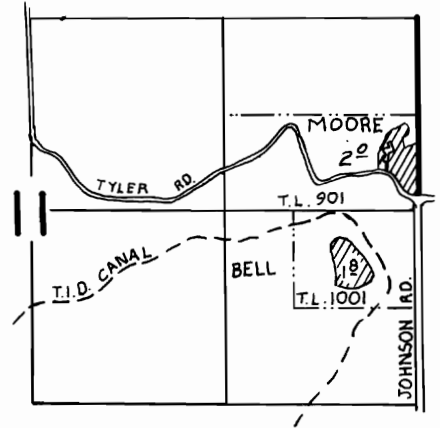
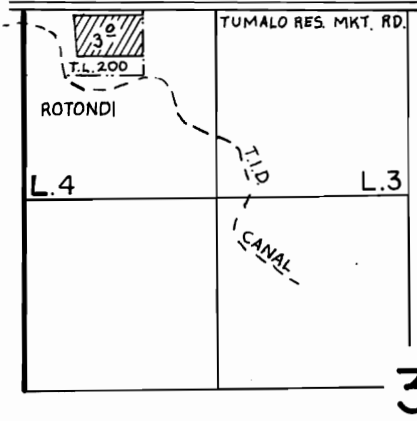



T.16S.,R.IIE.

T.17S.,R.IIE.

T.17S.,R.IIE.

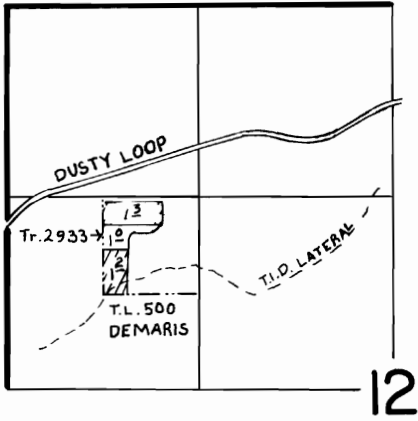

T.16S.,R.IIE.,W.M.

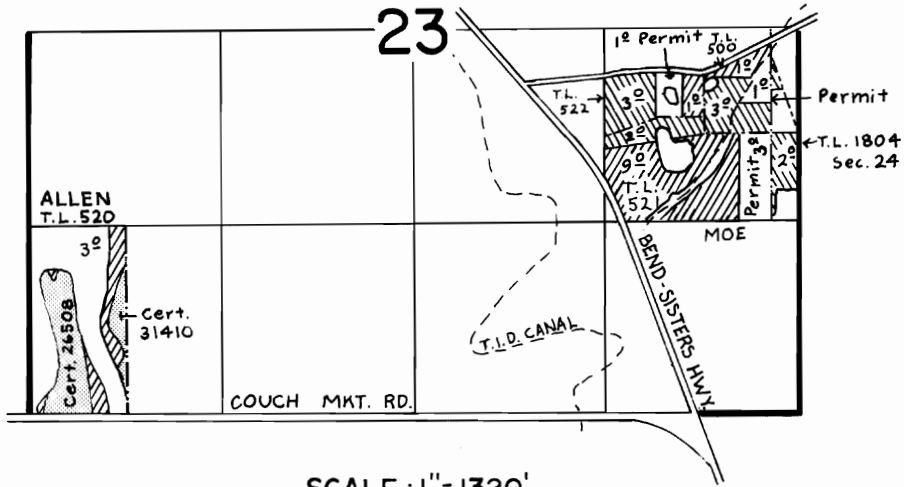

SCALE : 1" = 1320'

### FINAL PROOF SURVEY


UNDER   
 TRANSFER NO. 5640 AND   
  
 PART OF TRANSFER NO. 3872 2 of 3

IN NAME OF  
**TUMALO I.D. & VARIOUS OWNERS**

Surveyed APRIL 3, 1986, by LESLIE OLSON and  
 thru JUNE 16 1986 M. J. MATTICK

v. 35 p. 236  
 v. 39 p. 244

# T.16S.,R.12E.,W.M.

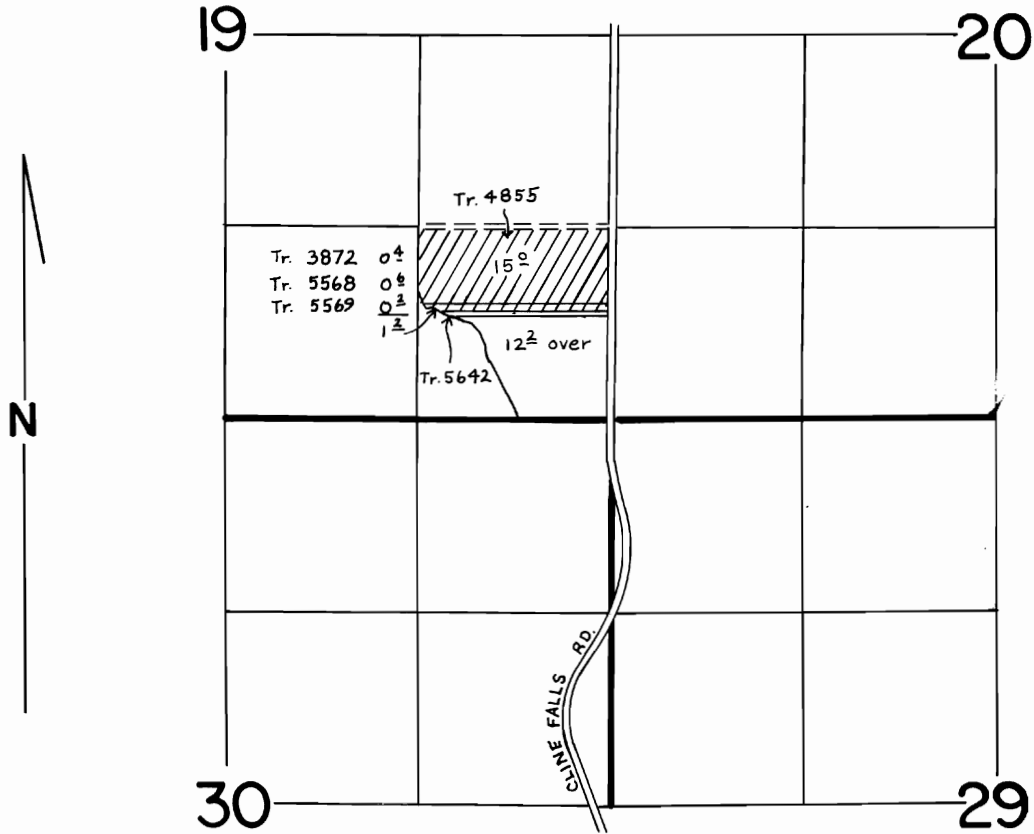

SCALE: 1" = 1320'

## FINAL PROOF SURVEY

UNDER

TRANSFERS 4855 & 5568

AND PARTS OF 3872 & 5569

IN NAME OF

**C.D. ROSE**

Surveyed MAY 14 1986., by M.J. MATTICK.....

REVISED  
5-11-87 LHM