
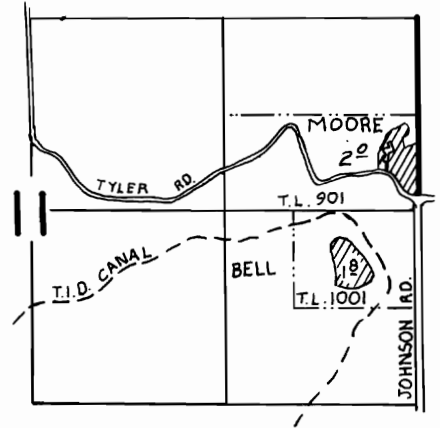
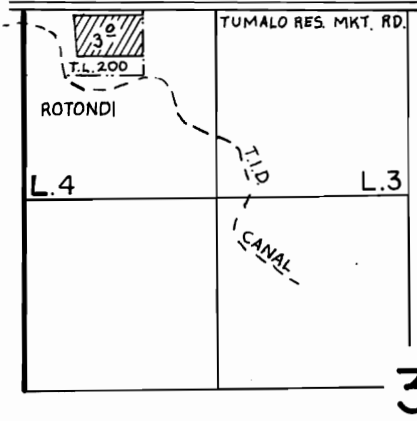



T.16S.,R.IIE.

T.17S.,R.IIE.

T.17S.,R.IIE.

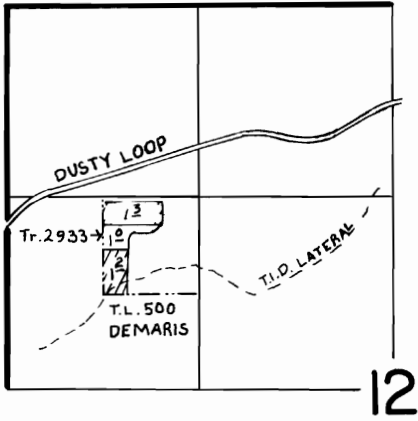

T.16S.,R.IIE.,W.M.

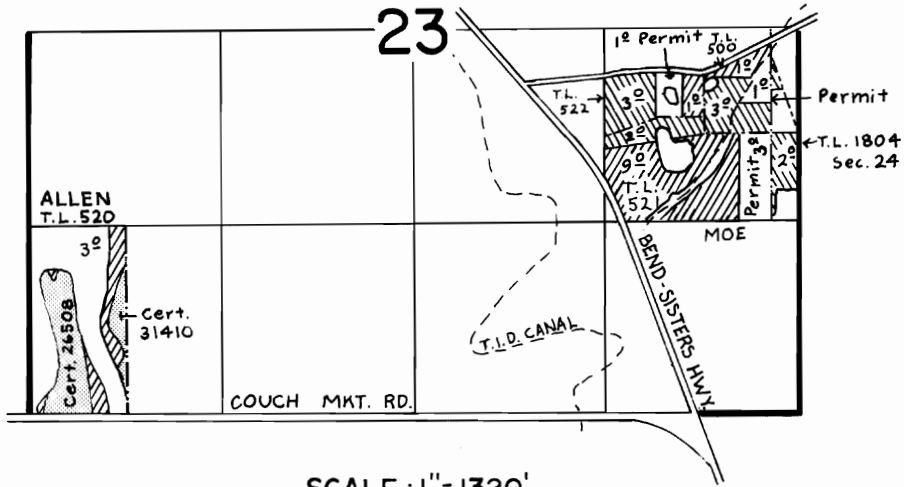

SCALE : 1" = 1320'

FINAL PROOF SURVEY

UNDER
 TRANSFER NO. 5640 AND

 PART OF TRANSFER NO. 3872 2 of 3

IN NAME OF
TUMALO I.D. & VARIOUS OWNERS

Surveyed APRIL 3, 1986, by LESLIE OLSON and
 thru JUNE 16 1986 M. J. MATTICK

v. 35 p. 236
 v. 39 p. 244