


T.17S.,R.47E.,W.M.

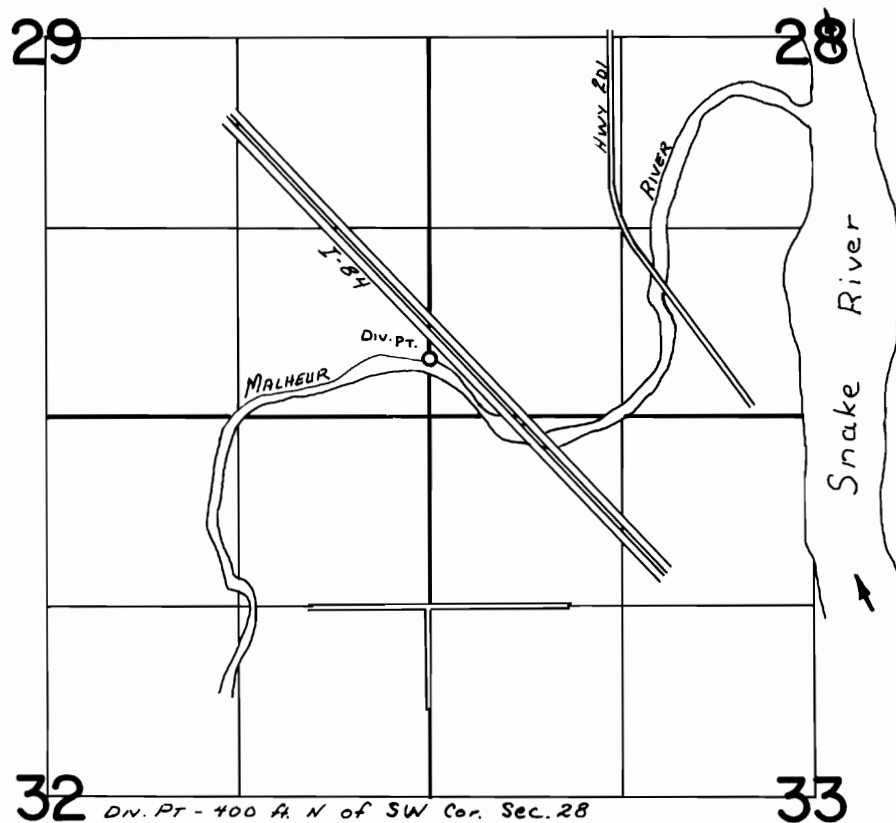

FINAL PROOF SURVEY
UNDER

Transfer No 3876
Application No. Permit No.

IN NAME OF

THAYER CATTLE CO.

Surveyed Aug. 19... 1983., by ..L...M...TOLL.....