

RECEIVED T-3879

JUL - 2 1979

SEC. 12, T18S, R12E, WM WATER RESOURCES DEPT SALEM, OREGON

SECTION 12, T18S, R12E, WM DESCHUTES COUNTY

RECEIVED

MAY 8 1978


WATER RESOURCES DEPT. SALEM, OREGON

RECEIVED

FEB 9 1978

WATER RESOURCES DEPT. SALEM, OREGON

RECEIVED JUL 28 1978 WATER RESOURCES DEPT. SALEM, OREGON

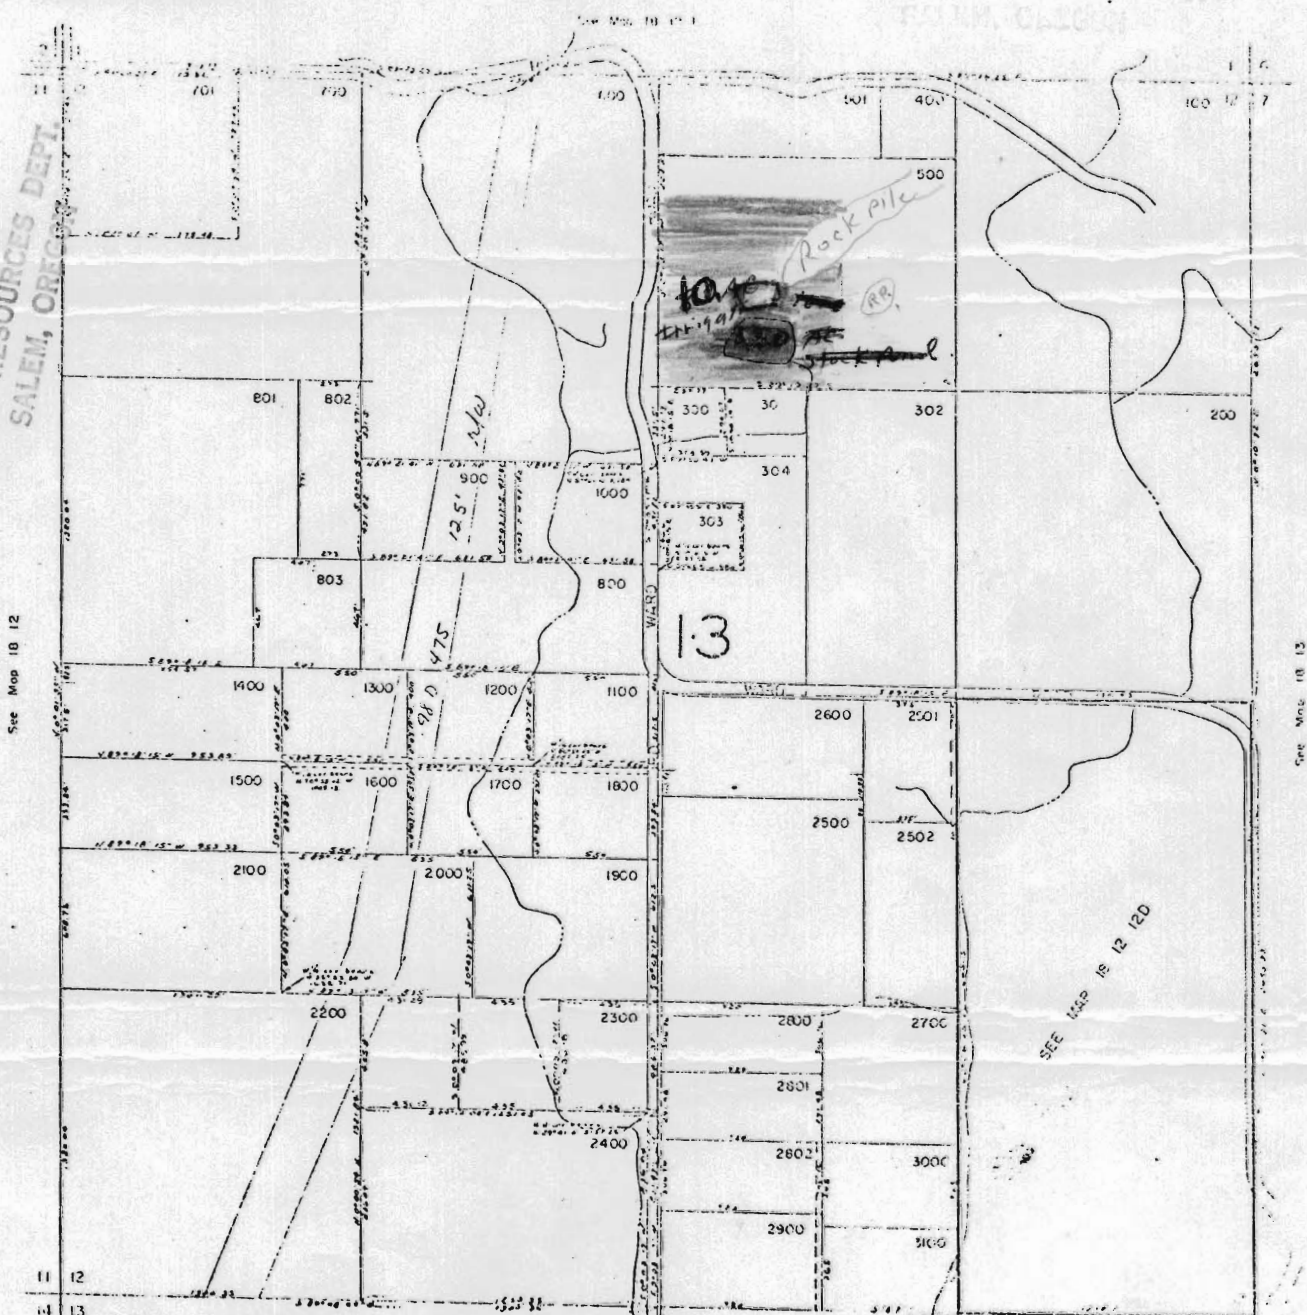

See Map 18 12

See Map 18 13

In red 10.0 AC total

See Map 18 12 13

Transferred to; NW 1/4 of NE 1/4 Ralph Bassett from D. Gaines S 1/2 of NW 1/4 of NE 1/4 18-12-17

~~2.0 AC pond stock use~~ Red doesn't want with stock pond 5/4/78
10.0 AC Irrigation use Pink

RECEIVED

T-3879

RECEIVED

MAY 8 1978

JUL - 2 1979

WATER RESOURCES DEPT
SALEM, OREGON

WATER RESOURCES DEPT. NW1/4 NE1/4 SEC 17 T18S R12E W.M.
SALEM, OREGON DESCHUTES COUNTY


18 12 17AD

FEB 9 1978

See Map 18 12 17A

RECEIVED
JUL 23 1978
WATER RESOURCES DEPT.
SALEM, OREGON

See Map 18 12 17A

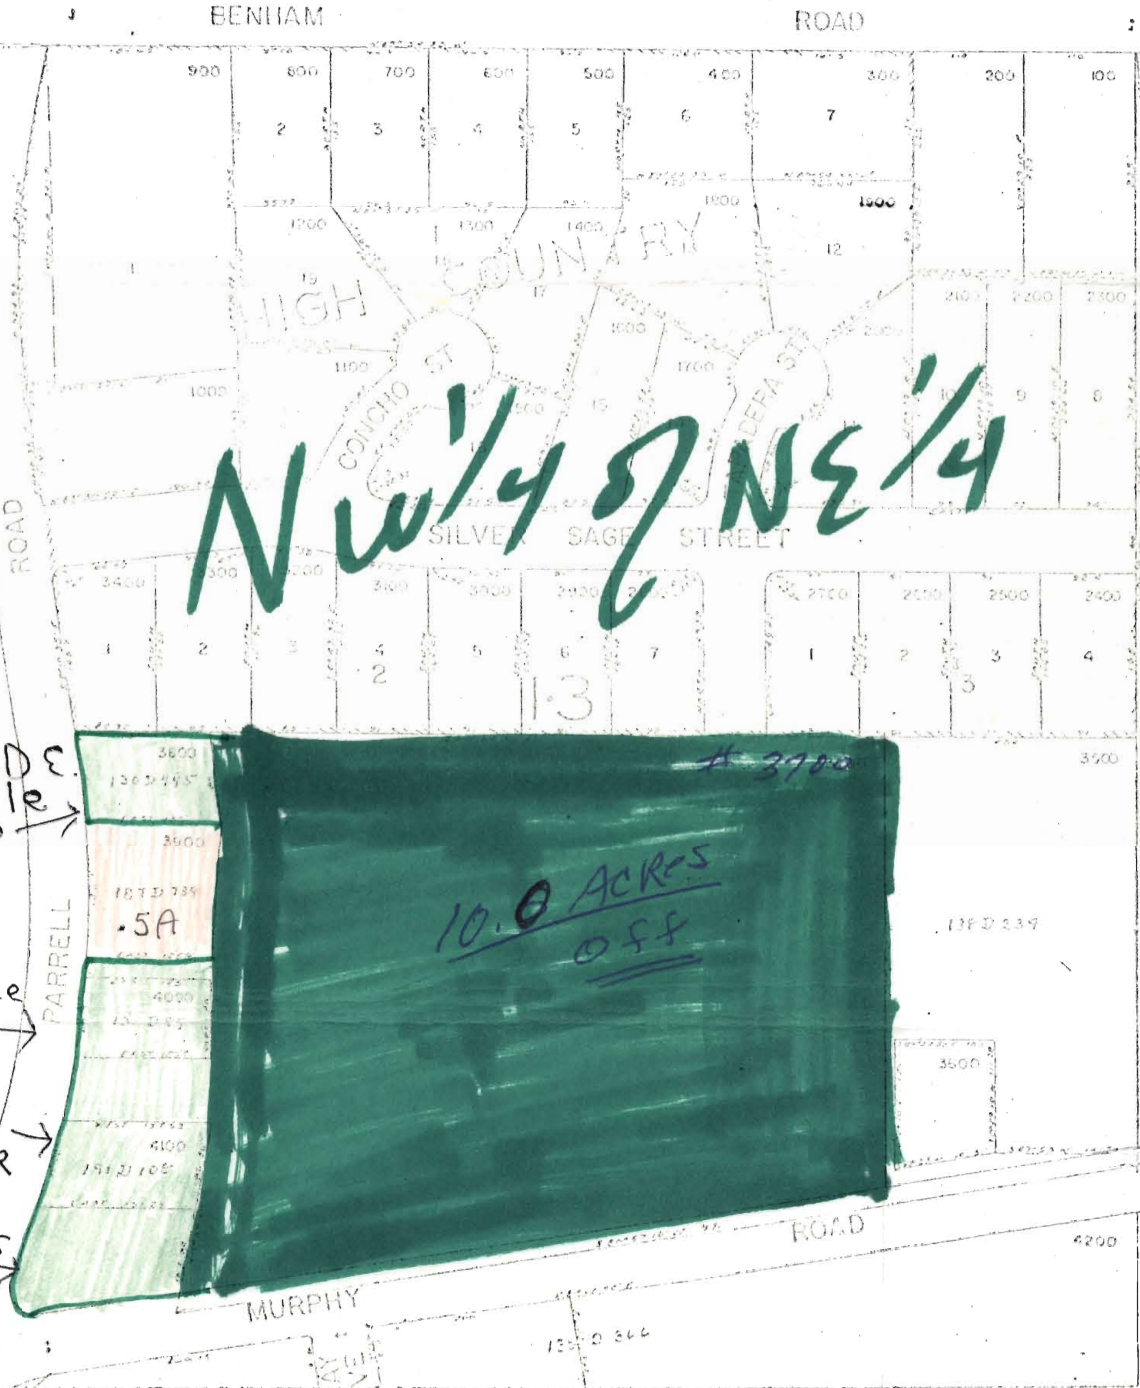

Harold E.
#3800

Douglas & Darlene
Gaines

#4100
Shirley Newer

D. & D. Gaines
HAMILTON ROAD

WATER RESOURCES DEPT.
SALEM, OREGON

See Map 18 12 17A

Under name of E.L. Loy Pg. 27 in Deschutes River Decree
S 1/2 of NW 1/4 of NE 1/4 18-12-17 10.0 acres off in Green

geb

18 12 17AD