


T-3880

RECEIVED
MAY 2 1978
WATER RESOURCES DEPT.
SALEM, OREGON

SECTION 22, T18S, R12E, W4E
DESCHUTES COUNTY
OR-960

RECEIVED
FEB 9 1978
WATER RESOURCES DEPT.
SALEM, OREGON

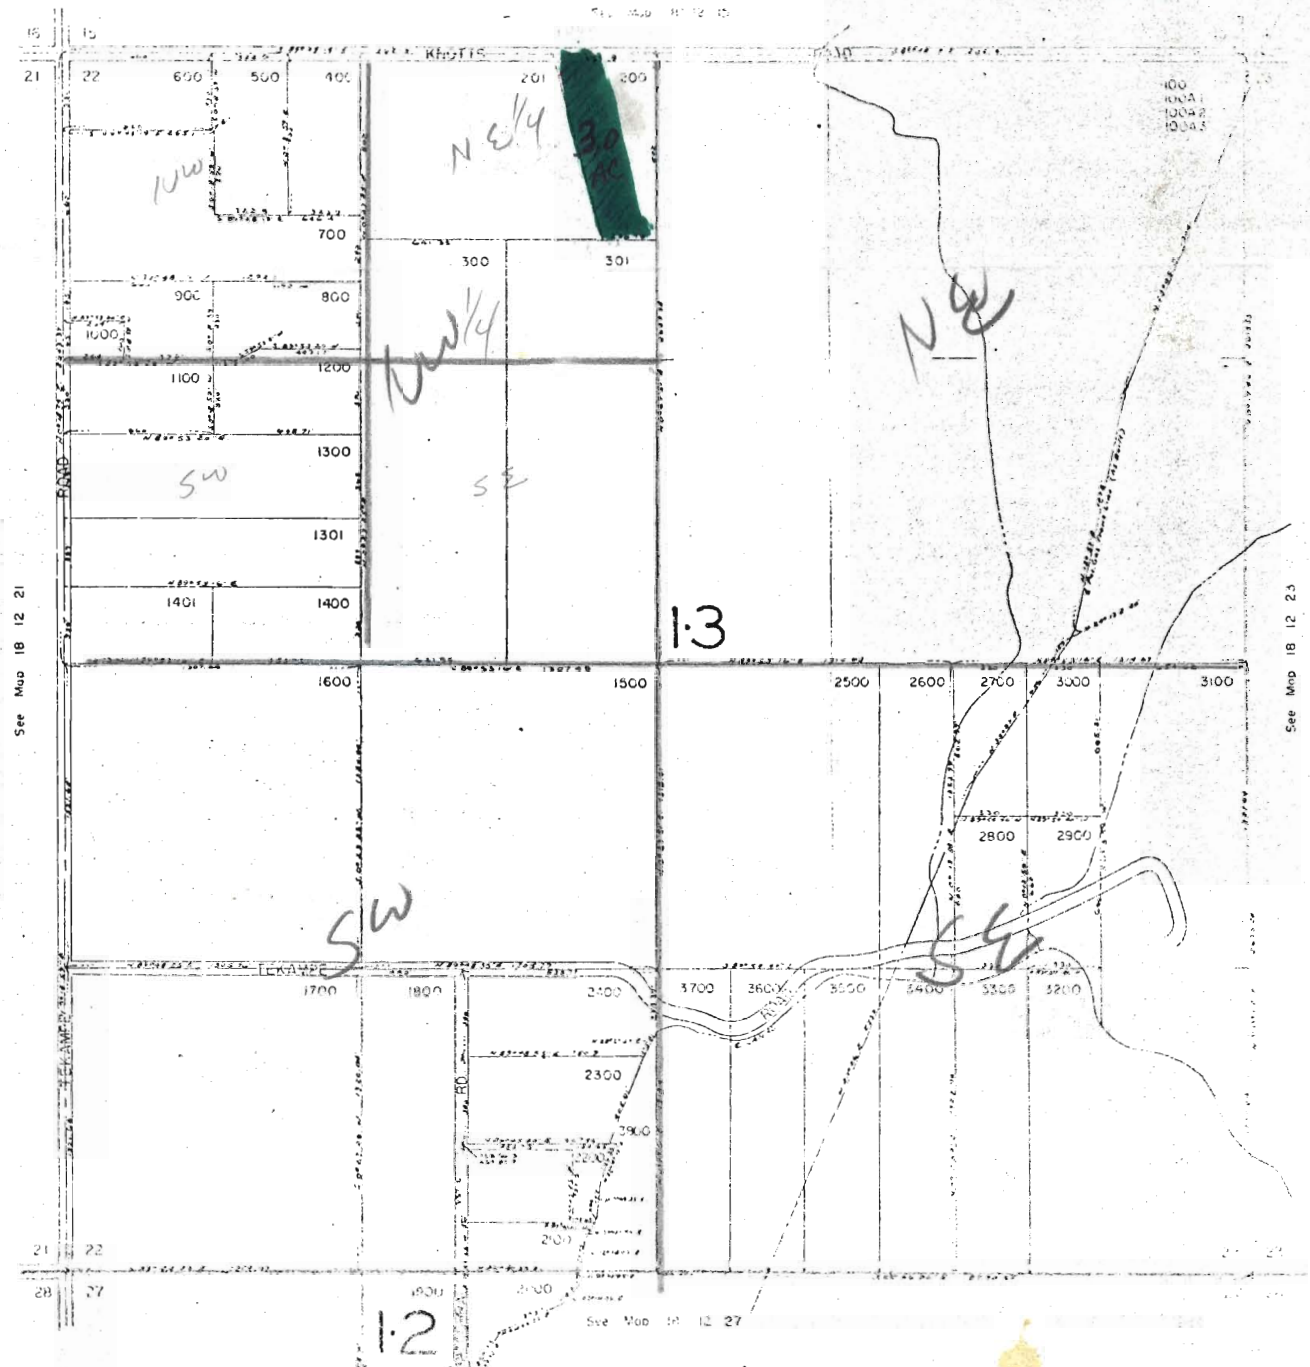

18-12-22 NE $\frac{1}{4}$ of NW $\frac{1}{4}$ lot # 200 Don Guiley sold 3.0 water rights off in green