


T.14S. R.11E. W.M.

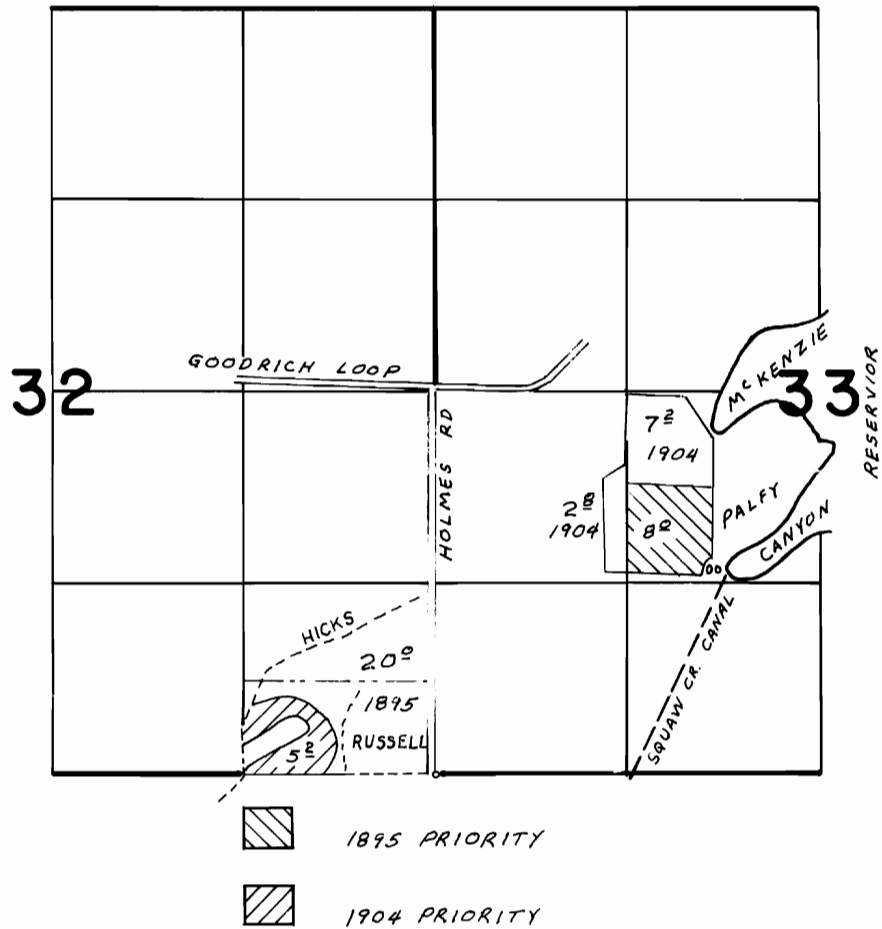

FINAL PROOF SURVEY UNDER

TRANSFER NO. 3888

Application No. Permit No.

IN NAME OF

STEVE PALFY

.....A. GORDON RUSSELL.....

Surveyed MAY. 28... 1980., by L.H. NUNN.....