


T. 39S., R. 1E., W.M.

NE 1/4 SW 1/4

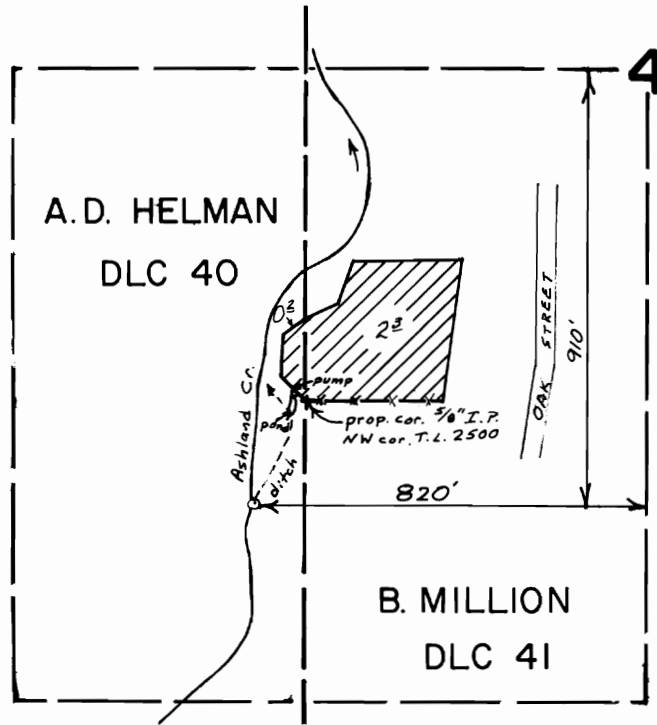

FINAL PROOF SURVEY
UNDER

Transfer no. 3899

Application No. Permit No.
IN NAME OF

CORA KLINGER

Surveyed JUNE 1, 1979, by B.R. SUND

scale: 1" = 400'