


# T.14S. R.6W.W.M.

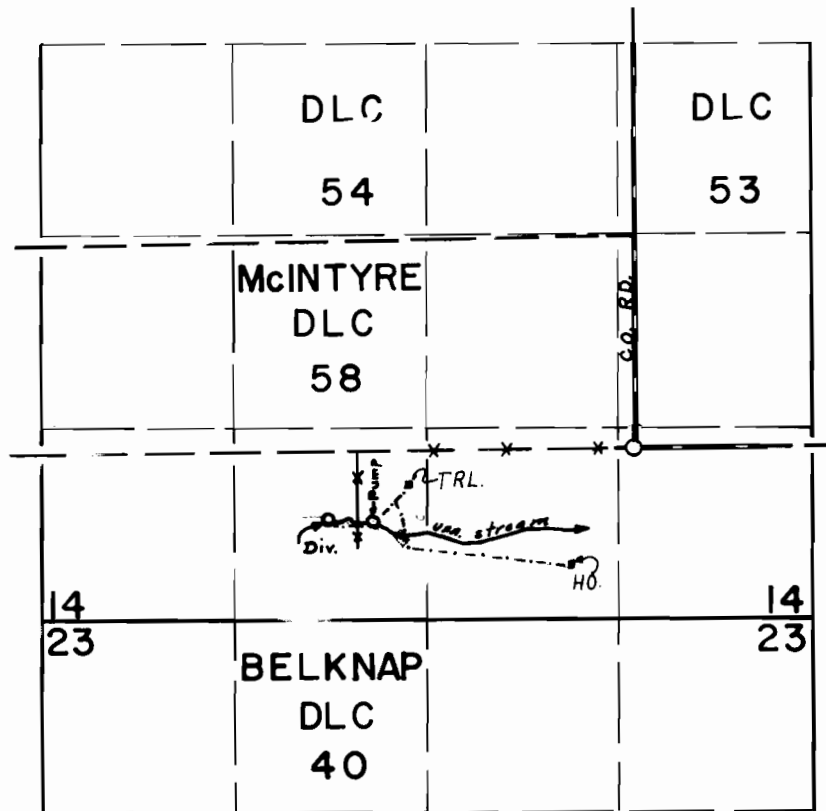

DIV: 500'S E 2100'W FROM SE COR McINTYRE DLC 58

## FINAL PROOF SURVEY UNDER

Application No. 52865 Permit No. 37829  
IN NAME OF

WILLIAM & DIANA GAMACHE

Surveyed APR. 22. 1976., by C.R. KING.....