


T.14S. R.12E. W.M.

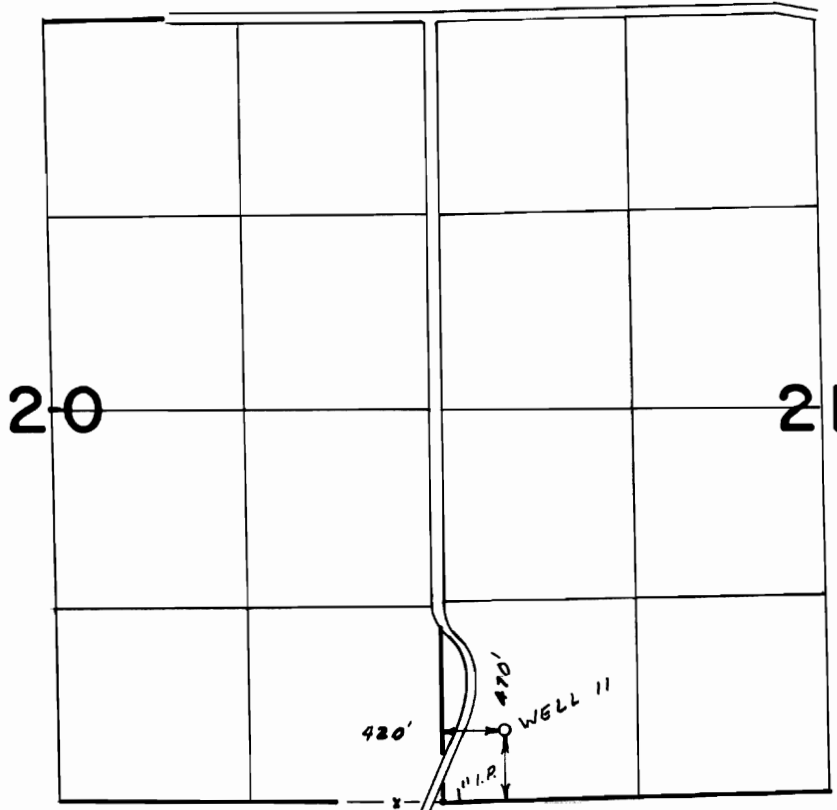

FINAL PROOF SURVEY
UNDER

TRANSFER 3915
Application No. Permit No.
IN NAME OF

..... JACK LIDELL

Surveyed OCT. 31. 1978, by L.H. NUNN.....