


T.2N. R.11E. W.M.

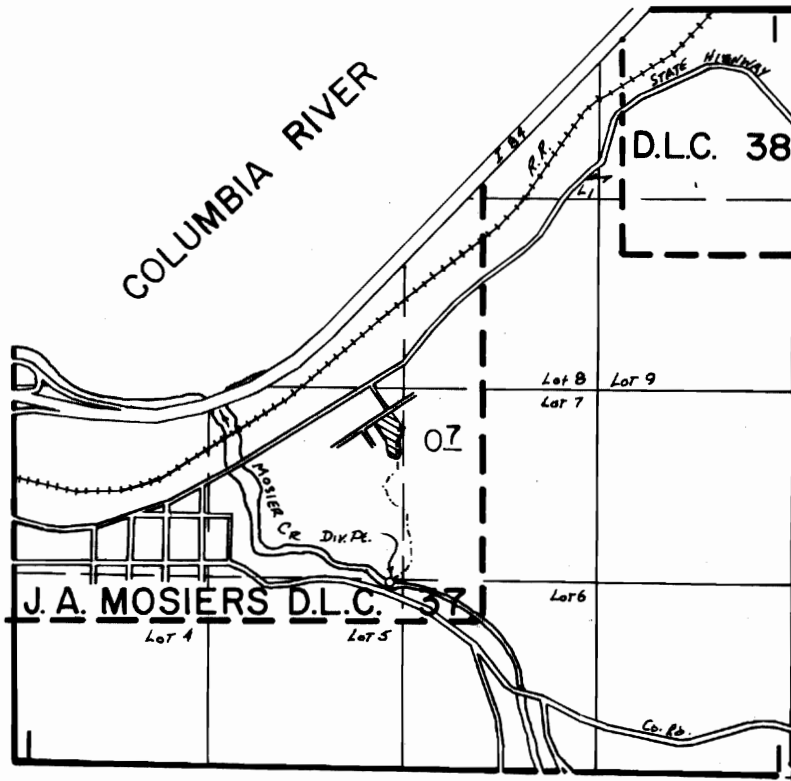

FINAL PROOF SURVEY
UNDER

Transfer No. 3916
Application No. _____ Permit No. _____
IN NAME OF

_____ EDWARD B. DIXSON _____

Surveyed March 10 1982, by T. PAUL _____