


T. 2N., R. 27E., W.M.

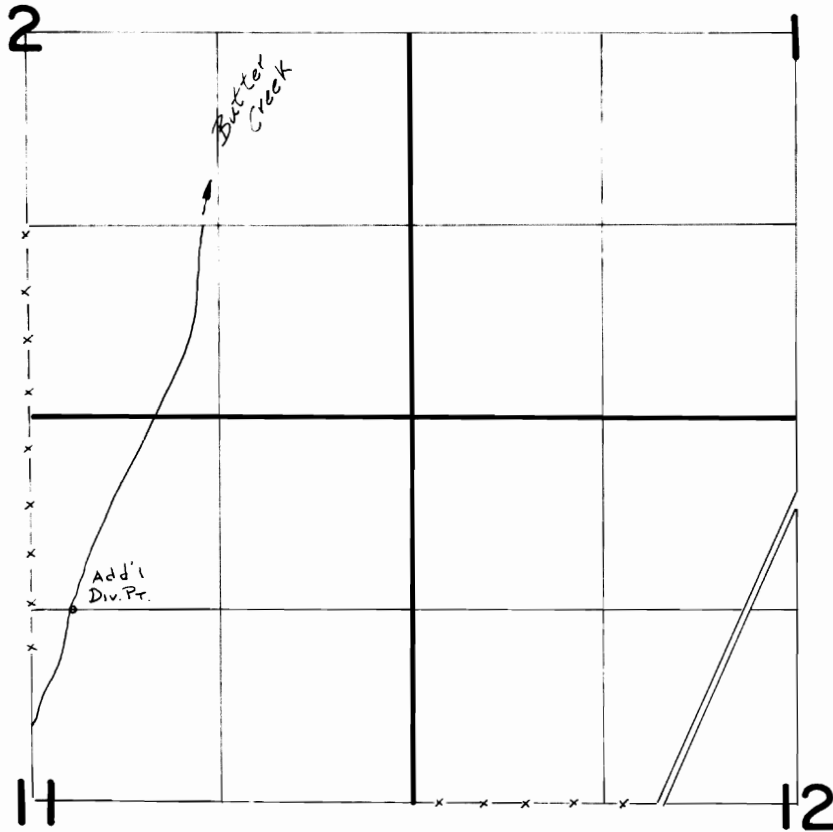

Add'l Div. Pt. LOCATED 1330'S. & 270'E FROM N¹/₄ COR. SEC. 11

FINAL PROOF SURVEY

UNDER

TRANSFER 3921

IN NAME OF

.....HALE.....BROTHERS.....FARMS.....

Surveyed 11-18..... 19.85., by V. L. Church.....

SCALE: 1" = 1320'