


T.1 & 2S., R. 25E., W. M.

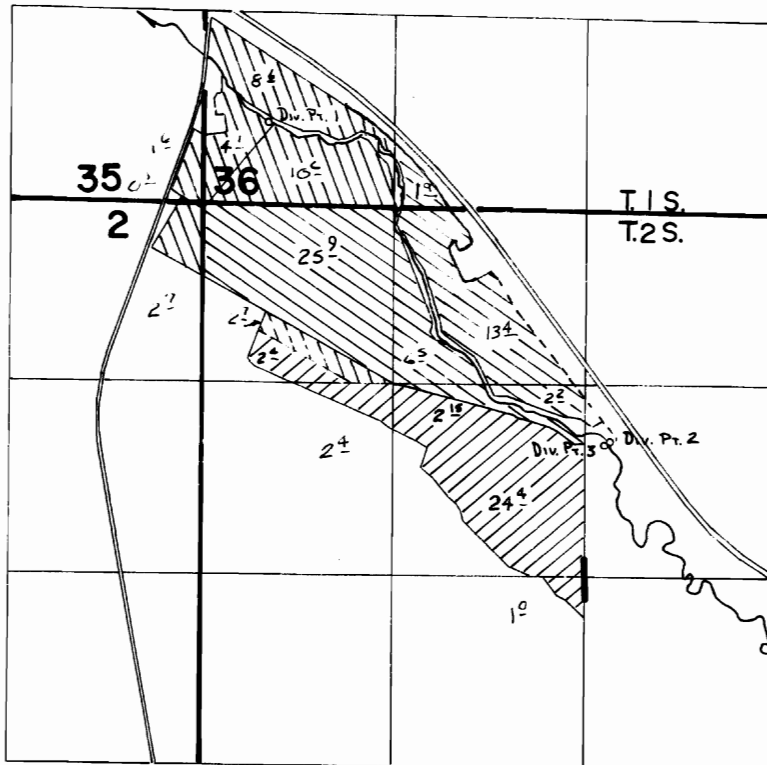

Div. Pt. 1 Loc: 560' N. & 450' E. FROM SW COR. SEC. 36

Div. Pt. 2 Loc: 920' N. & 160' E. FROM CENTER SEC. 1

Div. Pt. 3 Loc: 910' N. & 140' E. FROM CENTER SEC. 1

FINAL PROOF SURVEY
UNDER

TRANSFER 4141, 3945

IN NAME OF

HAROLD S. HUBER & JAMES S. BLOODSWORTH

Surveyed July 14, 1983, by *E. L. Church*

-  1883 (T-4141)
-  1890 (T-3945)
-  1902 (T-4141)