


T. 39 S., R. 2 E., W.M.

Sec. 19

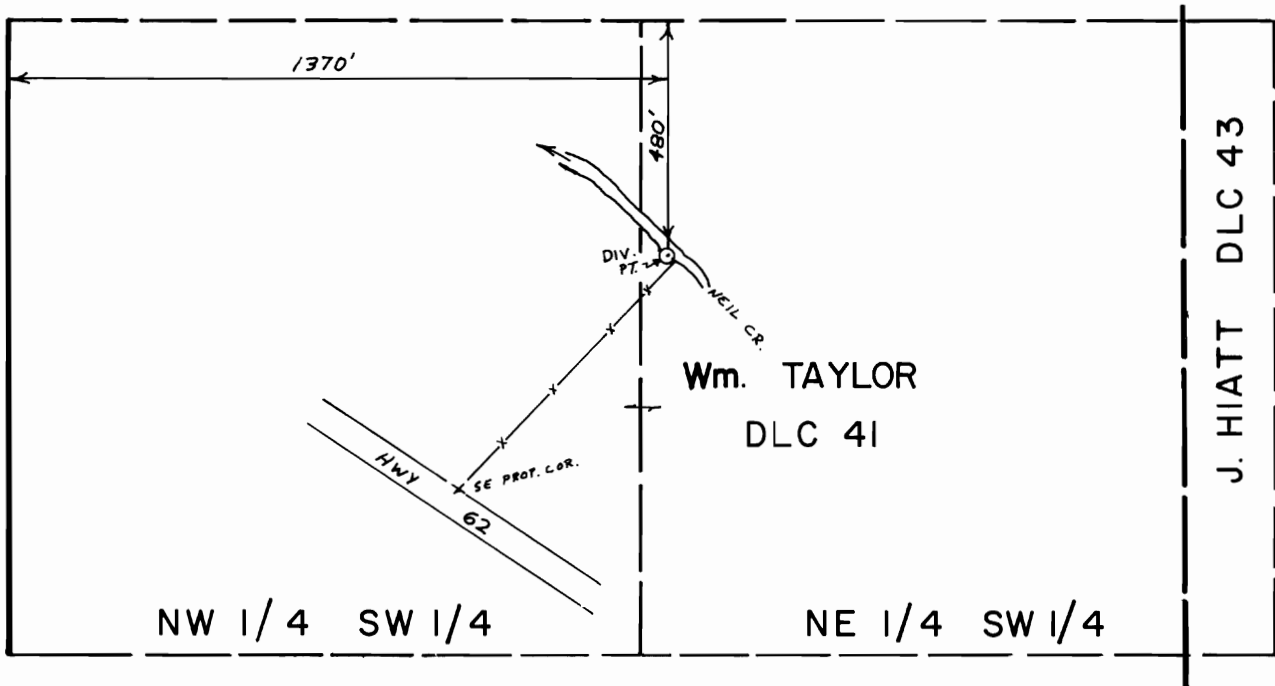

Scale 1" = 400'

FINAL PROOF SURVEY
UNDER

Transfer no. 3947

Application No. Permit No.
IN NAME OF

.....ORION.....WELLS.....

Surveyed March 28, 1980, by B.R. SUND.....