


T. 1N. R. 32E. W.M.

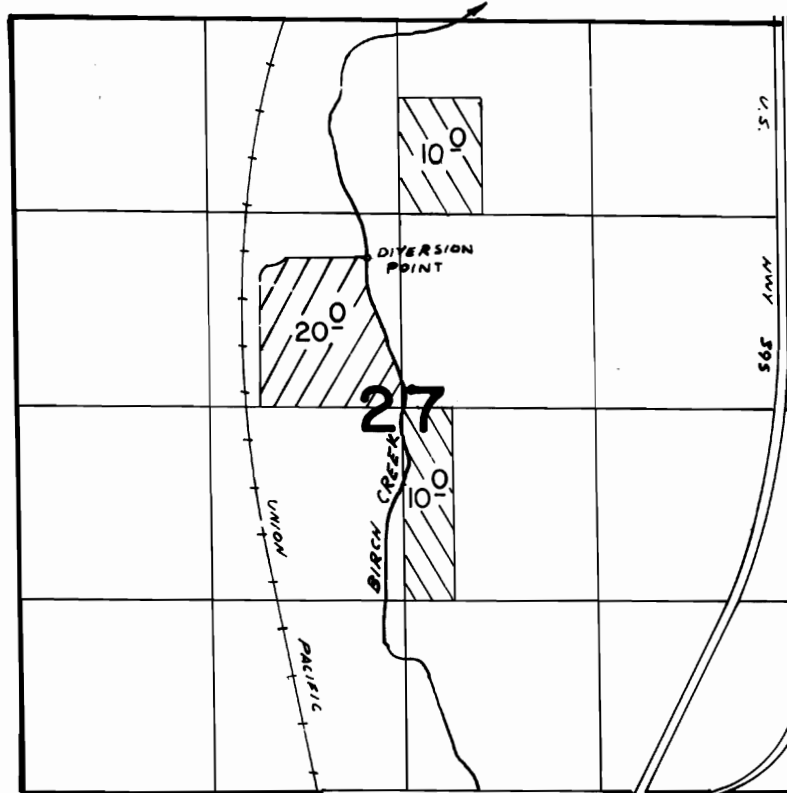

DIVERSION POINT 1020'N & 220'W FROM CENTER SEC 27



TRANSFER 3870



TRANSFER 3882

FINAL PROOF SURVEY

UNDER

TRANSFER 3870
TRANSFER 3882
TRANSFER 3948

Application No. Permit No.
IN NAME OF

..... **FRANKLIN HOEFT**

Surveyed 2-15 1979, by R. BARWIN