


# T. 1N. R. 32E. W.M.

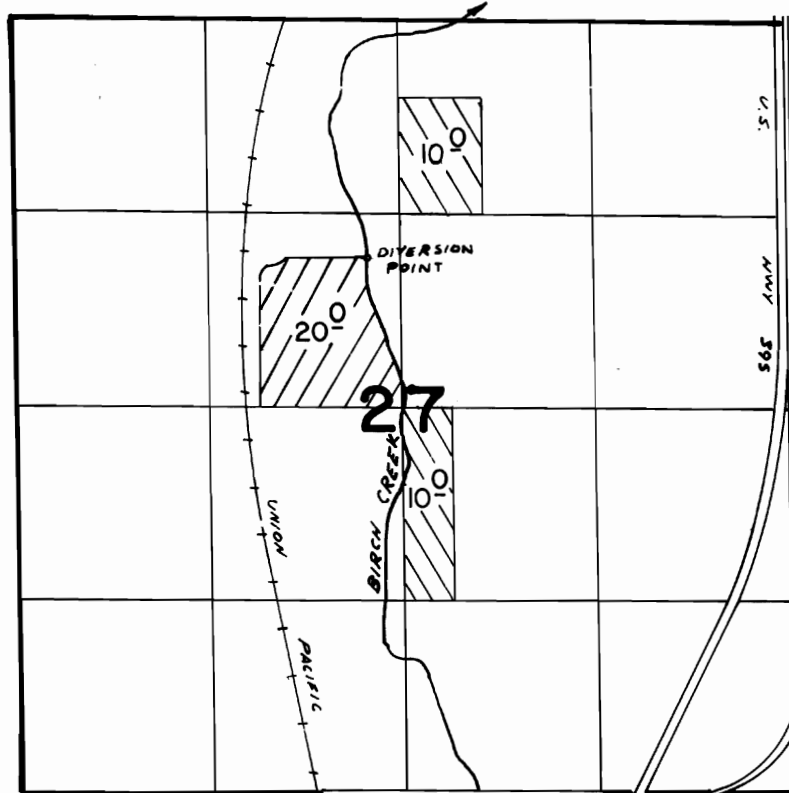

DIVERSION POINT 1020'N & 220'W FROM CENTER SEC 27



TRANSFER 3870



TRANSFER 3882

## FINAL PROOF SURVEY

UNDER

TRANSFER 3870  
 TRANSFER 3882  
 TRANSFER 3948

Application No. .... Permit No. ....  
 IN NAME OF

.....FRANKLIN HOEFT.....

Surveyed 2-15..... 1979., by R. BARWIN.....