


T. 35 S., & T. 36 S., R. 1 E., W.M.

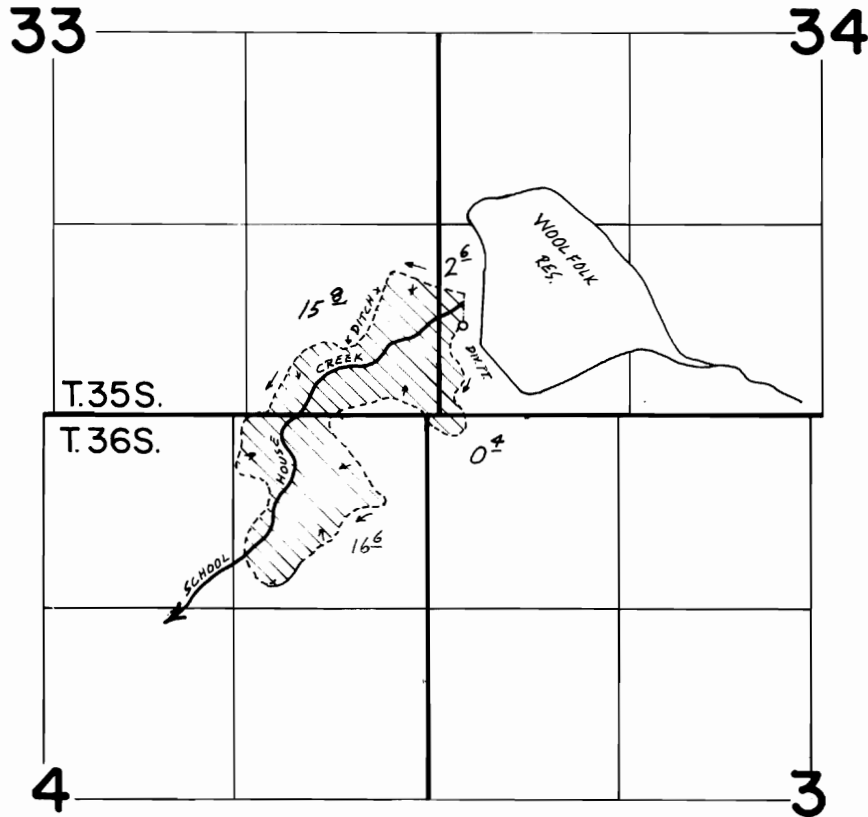

Scale: 1" = 1320'

FINAL PROOF SURVEY
UNDER

Transfer No. 3949

Application No. Permit No.
IN NAME OF

..... JAMES L. SCHEFFEL

Surveyed June 12, 1984, by B.S. JAMES