


T.35 S., R. 1 E., W.M.

T.36 S., R. 1 W., W.M.

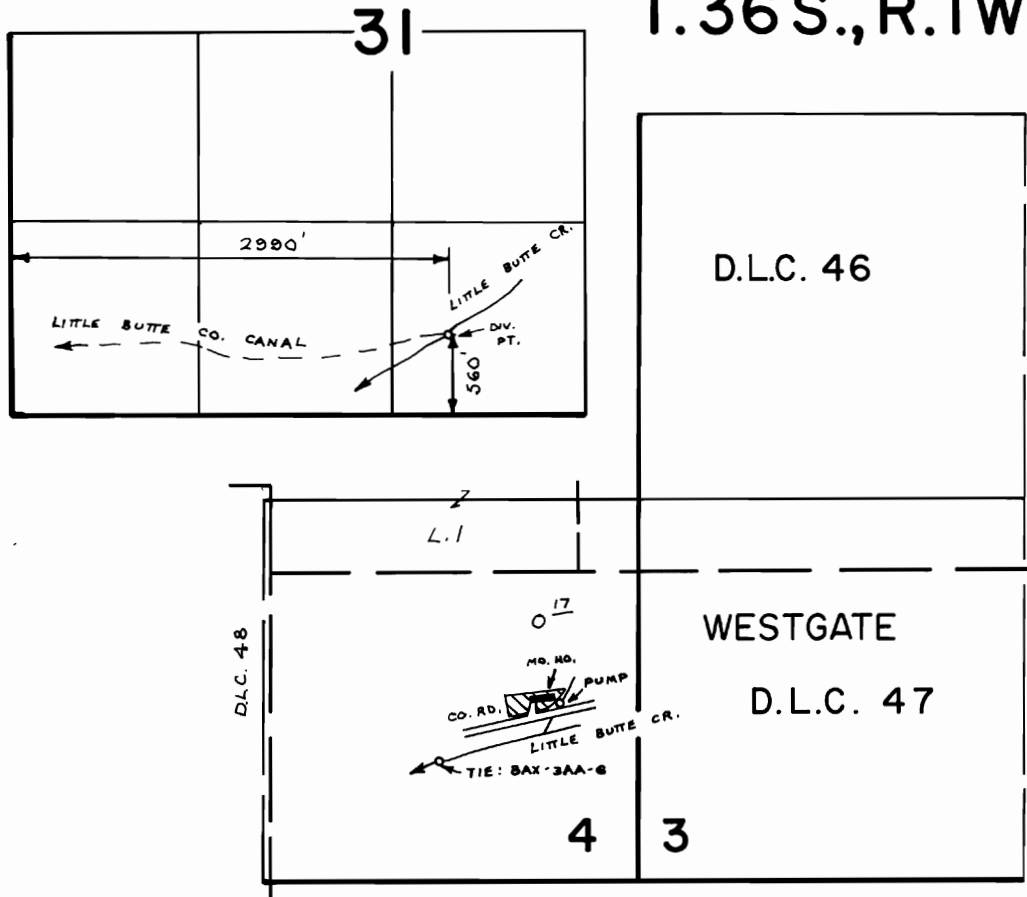

SCALE : 1" = 660 FT.

**FINAL PROOF SURVEY**  
UNDER

Transfer No. 3950

Application No. .... Permit No. ....  
IN NAME OF

ELOISE DISTELL

Surveyed AUG. 24 1978, by B. SUND

D.H.M.  
P.T.S. - 1978-14-C  
& BAX-3AA-6