


# T13S. R7W. WM.

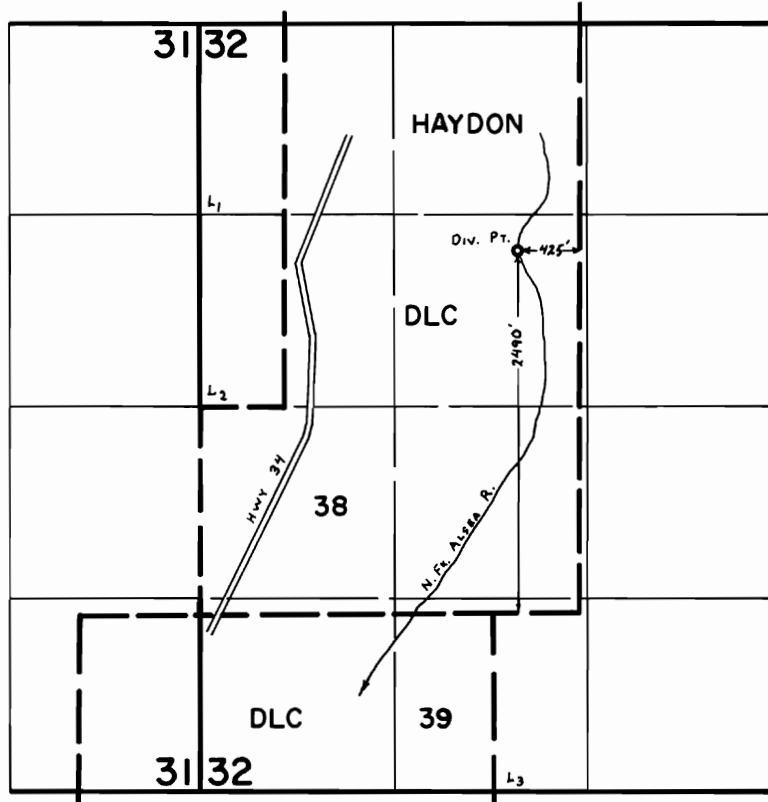

## FINAL PROOF SURVEY UNDER

Transfer No. 3951  
Application No. .... Permit No. ....  
IN NAME OF

**FLOYD M. & MIMI K. STOUT**

Surveyed Aug. 16, 1979, by C. L. HUGHES