



T.13S.,R.30E.,W.M.

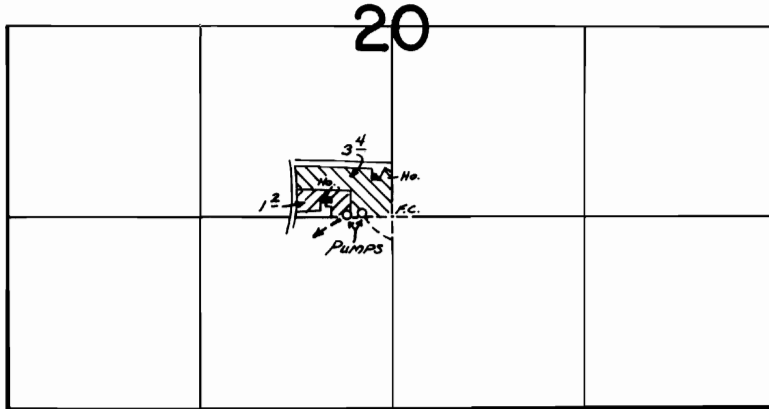

 - THOMPSON
 - MCKERN

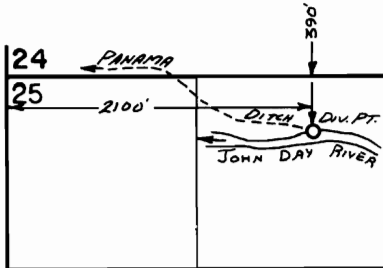

FINAL PROOF SURVEY
UNDER

Transfer No. 3954

Application No. Permit No.

IN NAME OF
**ELMER THOMPSON &
DERROL MCKERN**

Surveyed Sept. 6, 1983, by R. W. Cettel.....