


T.29S.R.7W.W.M.

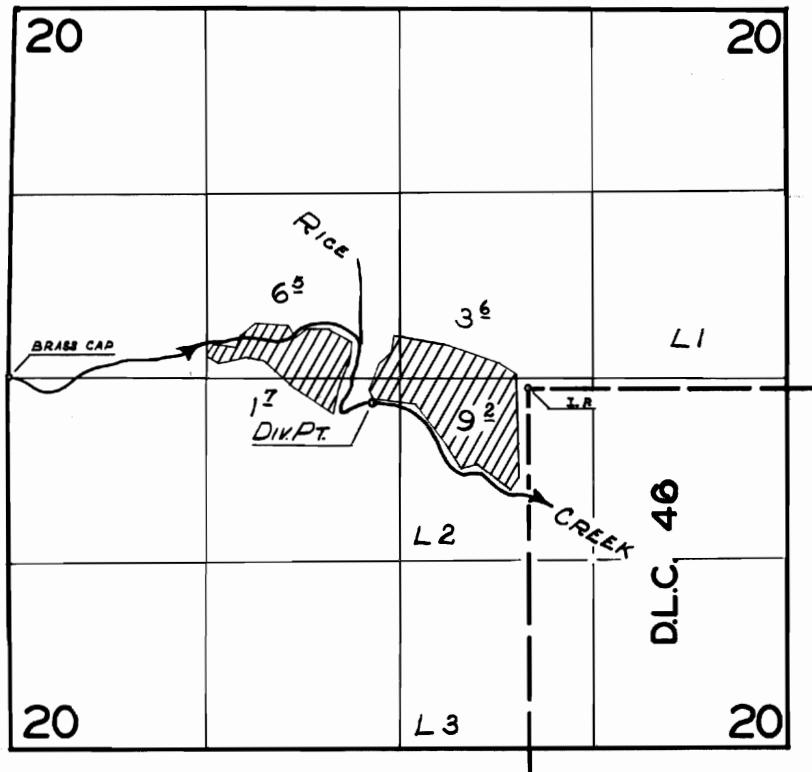

FINAL PROOF SURVEY
UNDER

Application No. 28129 Permit No. 22141
IN NAME OF

ELTON J. ZUVER

Surveyed AUGUST 31 1961, by C.O. BARTELS