


DESCHUTES COUNTY

SCALE 1" = 400'

T-3962

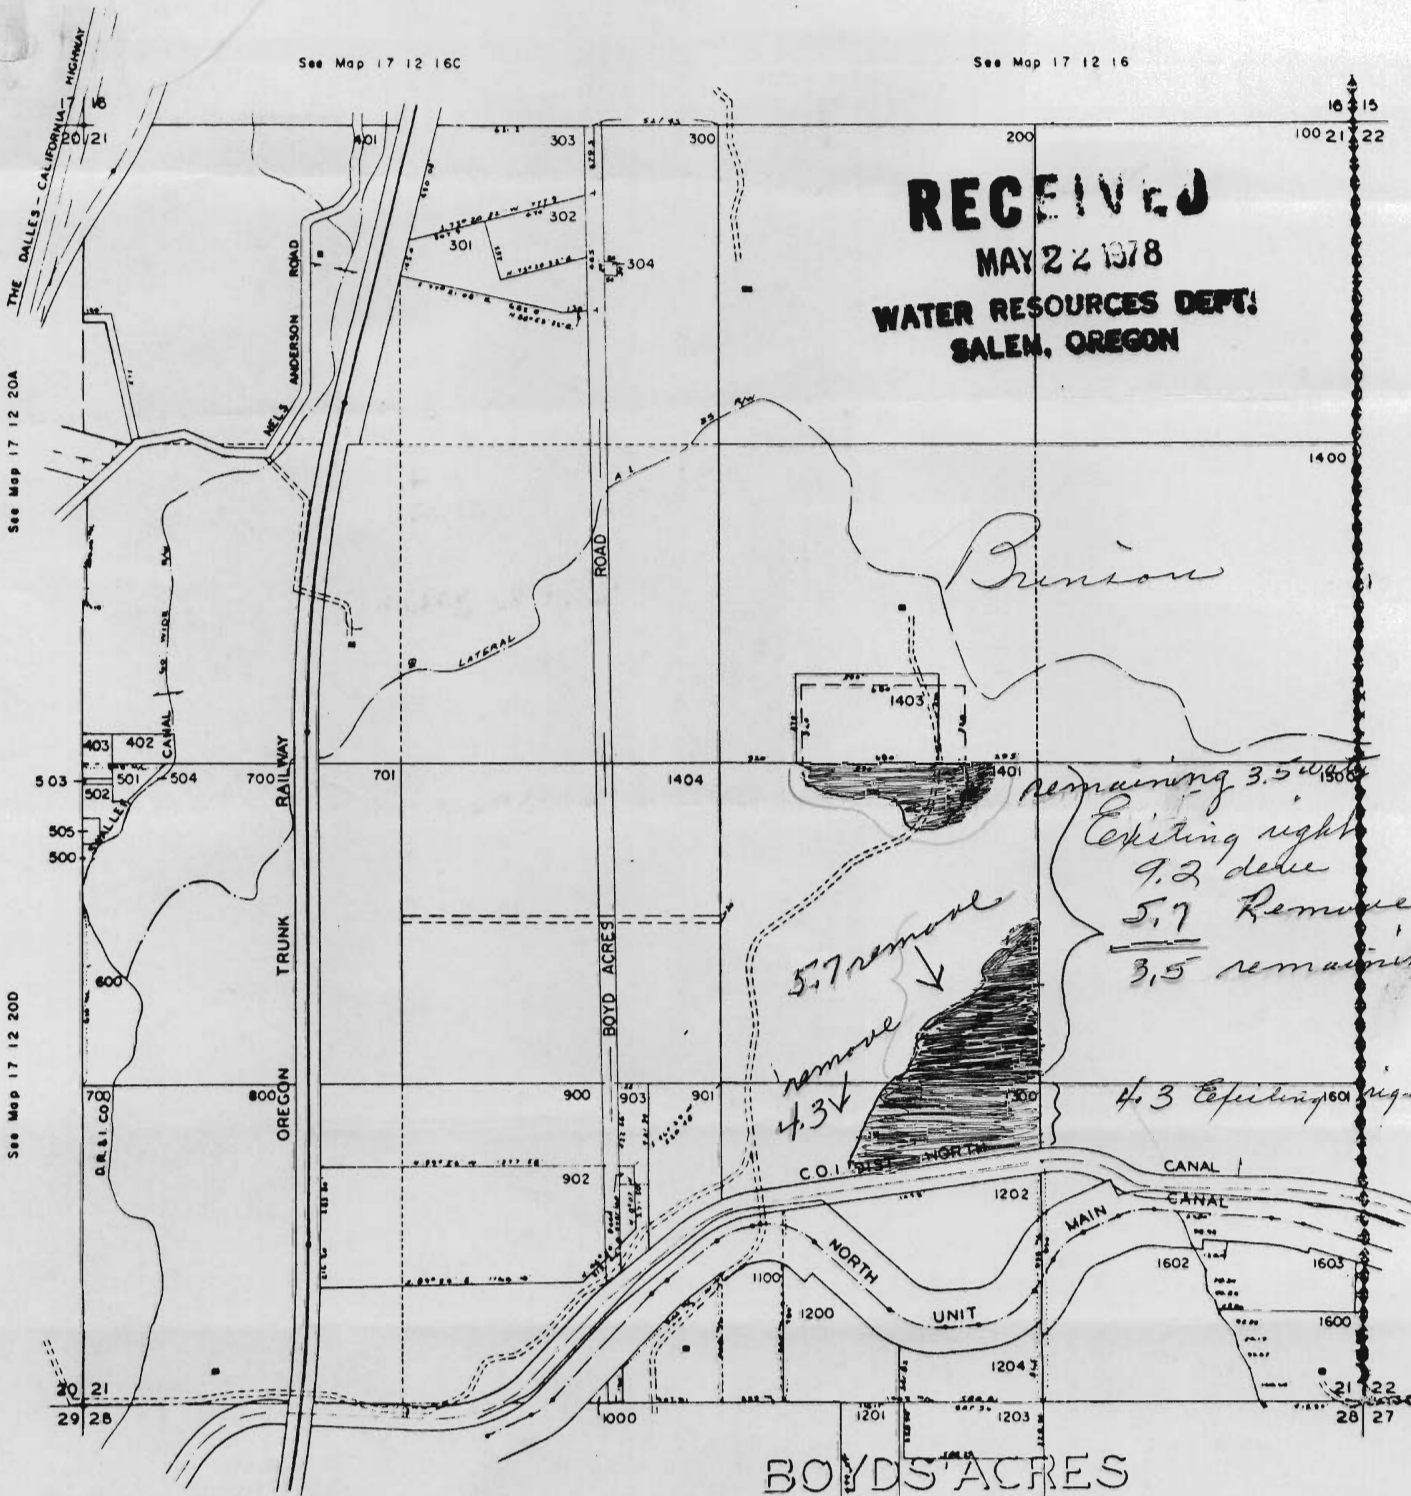

RECEIVED
MAY 22 1978
WATER RESOURCES DEPT.
SALEM, OREGON

BOYD'S ACRES

33-16-12

SECTION T. S. R. E.W.M.

T-3962

1" = 400'

Bernard Burke

Mr. Burke has under ground sprinklers on all three forties

10 water from Brinson
↓
5 water from Brinson

RECEIVED
MAY 22 1978
WATER RESOURCES DEPT.
SALEM, OREGON

33



