


T.4S. R.2W. W.M.

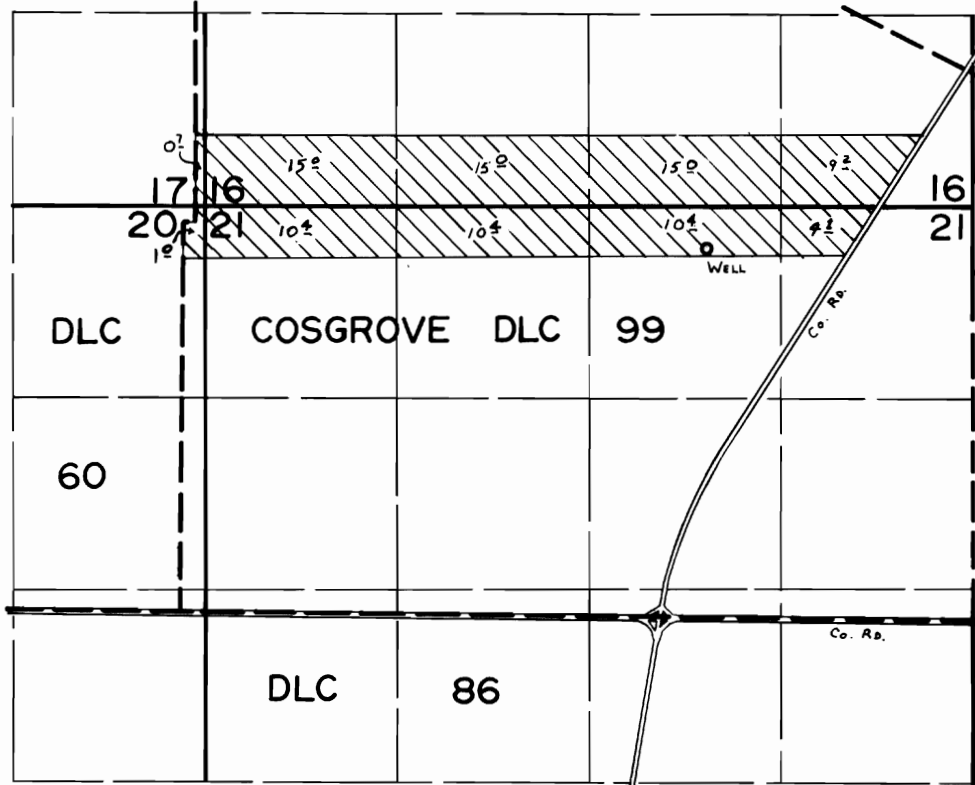

WELL Loc: 2500' N. & 3610' E. fr. S.W. Cor. COSGROVE D.L.C. 99.

FINAL PROOF SURVEY UNDER

Transfer No. 3964

Application No. Permit No.

IN NAME OF

TERRANCE & JOYCE KIRK.....

Surveyed July 10, 1980, by G. L. Hughes.....